

LEFLORE

C-71

MISSISSIPPI  
 BOARD OF WATER COMMISSIONERS  
 416 North State Street  
 Jackson, Mississippi 39201

CODED

WATER WELL DRILLERS LOG  
 BUTANE GAS COMPANY

4-28-80

date well completed

19

OF GREENWOOD

Leflore

county well located

LANDOWNER:

Dewitt Corp.

GREENWOOD, MS 38930  
(mailing address)

description of formations encountered

from to

Clay	0	30
SAND & GRAVEL	30	100

CODED

WELL LOCATION:

sec. 17 T21N R2E  
 5 miles NW of SCHLATER  
 (distance) (direction) (nearest town)

WELL PURPOSE: FRR  
 (home, irrigation, municipal, industrial)

WELL COMPLETION DATA:

- (1) diameter (inches) 16
- (2) total depth (feet) 100
- (3) static water level (feet) 30 below top of ground.
- (4) casing Steel, 60 (material), (depth)  
16" (size) If telescope see back.
- (5) screen 40, 60 (length), (depth to top)  
16" (size), Steel (material)
- (6) pump 60 (HP), 2500 (yield gpm)  
Diesel (type power)
- (7) electric log NO (yes or no)

(organization running log)

(8) how well bottom plugged Steel plate

DRILLERS REMARKS:


DEPT. OF NATURAL RESOURCES  
 BUREAU OF LAND & WATER RESOURCES

MAY 10 1980

RECEIVED

If well telescopes please sketch and show depths.

GROUND LEVEL

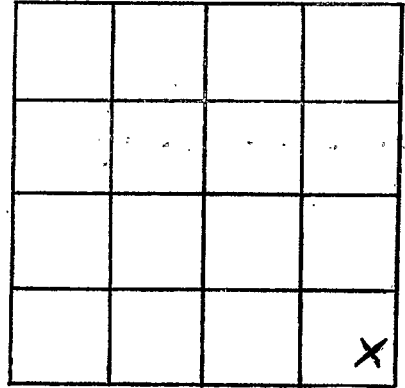

SECTION 17

Please indicate well location X.

ADDITIONAL INFORMATION

If more than one screen, show locations of each on sketch.