

LEFLORE

C-72

6-23-80

JUNE 23 1980
date well completed

MISSISSIPPI
BOARD OF WATER COMMISSIONERS CODED
416 North State Street
Jackson, Mississippi 39201

WATER WELL DRILLERS LOG
BUTANE GAS COMPANY

OF GREENWOOD
firm name

LEFLORE
county well located

LANDOWNER: DEWITT CORPORATION
Schlater, MS

(mailing address)

description of formations encountered	from	to
	CLAY	0
SAND	25	50
SAND & GRAVEL	50	100

WELL LOCATION:

sec 29 T 21 N R 2 E
5 miles N WEST of Schlater
(distance) (direction) (nearest town)

WELL PURPOSE: IRRIGATION
(home, irrigation, municipal, industrial)

WELL COMPLETION DATA:

- (1) diameter (inches) 16"
- (2) total depth (feet) 100'
- (3) static water level (feet) _____ below above top of ground.
- (4) casing STEEL, 60' (material) (depth)
16" (size) If telescope see back.
- (5) screen 40' 60' (length) (depth to top)
16" (size) STEEL (material)
- (6) pump 50 (HP) 2500 (yield gpm)
Electric (type power)
- (7) electric log No. (yes or no)
- (8) how well bottom plugged STEEL PLATE

CODED

DEPT. OF NATURAL RESOURCES
BUREAU OF LAND & WATER RESOURCES


JUL - 2 1980

RECEIVED

DRILLERS REMARKS:

If well telescopes please sketch and show depths.

GROUND LEVEL

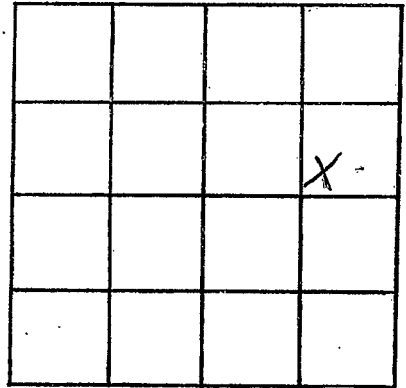

SECTION 29

Please indicate well location X.

ADDITIONAL INFORMATION

If more than one screen,
show locations of each on sketch.