

LEFLORE  
C 75  
10/8/90

MISSISSIPPI  
BOARD OF WATER COMMISSIONERS  
416 North State Street  
Jackson, Mississippi 39201

CODED

WATER WELL DRILLERS LOG

Oct 8 1980 BUTANE GAS COMPANY LEFLORE  
date well completed OF GREENWOOD county well located

LANDOWNER:	description of formations encountered	from	to
HAROLD COLEMAN	CLAY	0	16
Schlater, Ms.	SAND	16	20
(mailing address)	SAND & GRAVEL	20	80
	SAND, GRAVEL, ROCK, CLAY	80	90

WELL LOCATION:  
sec 34 T 21 N R 2 E  
2 1/2 miles WEST of SCHLATER  
(distance) (direction) (nearest town)

WELL PURPOSE: IRRIGATION  
(home, irrigation, municipal, industrial)

CODED

- WELL COMPLETION DATA:
- (1) diameter (inches) 16
  - (2) total depth (feet) 87
  - (3) static water level (feet) \_\_\_\_\_ below/above top of ground.
  - (4) casing STEEL 57'  
(material) (depth)
  - \_\_\_\_\_ If telescope see back.  
(size)
  - (5) screen 40 57'  
(length) (depth to top)  
16" STEEL  
(size) (material)
  - (6) pump 60 2500  
(HP) (yield gpm)  
ELECTRIC  
(type power)
  - (7) electric log No  
(yes or no)  
No  
(organization running log)
  - (8) how well bottom plugged  
STEEL PLATE

DEPT. OF NATURAL RESOURCES  
BUREAU OF LAND & WATER RESOURCES


OCT 16 1980

RECEIVED

DRILLERS REMARKS:

If well telescopes please sketch and show depths.

GROUND LEVEL

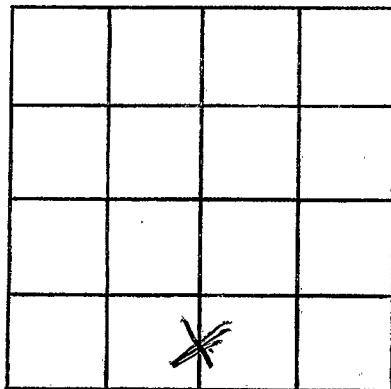

SECTION 34

Please indicate well location X.

ADDITIONAL INFORMATION

If more than one screen, show locations of each on sketch.