

MISSISSIPPI DEPARTMENT OF NATURAL RESOURCES

Bureau of Land and Water Resources

Southport Mall

P.O. Box 10631


Jackson, Mississippi 39209 CODED

WATER WELL DRILLERS LOG

Leflore
C 76
4-8-81

4-8-81 19 BUTANE GAS CO. OF GREENWOOD Leflore
 date well completed firm name county well located

LANDOWNER:	description of formations encountered	from	to
<u>HAROLD COLEMAN</u>			
<u>Schlater</u> (mailing address)	<u>Fine Sand</u>	<u>38</u>	<u>57</u>
WELL LOCATION:	<u>Sand + Pea Gravel</u>	<u>57</u>	<u>95</u>
sec. <u>33</u> T <u>21</u> N & R <u>2</u> E W	<u>Rock</u>	<u>95</u>	
<u>3</u> miles <u>W</u> of <u>Schlater</u> (distance) (direction) (nearest town)			
WELL PURPOSE: <u>FAR</u> (home, irrigation, municipal, industrial)			
WELL COMPLETION DATA:			
(1) diameter (inches) <u>16"</u>			
(2) total depth (feet) <u>95</u>			
(3) static water level (feet) <u>30</u> below above top of ground.			
(4) casing <u>Steel</u> , <u>55</u> (material), (depth)			
<u>16"</u> (size) if telescope see back.			
(5) screen <u>40</u> , <u>55</u> (length), (depth to top)			
<u>16"</u> , <u>Steel</u> (size), (material)			
(6) pump <u>30</u> , <u>1000</u> (HP), (yield gpm)			
<u>Elec</u> (type power)			
(7) electric log <u>No</u> (yes or no)			
<u></u> (organization running log)			
(8) how well bottom plugged <u>Steel Plate</u>			
DRILLERS REMARKS:			

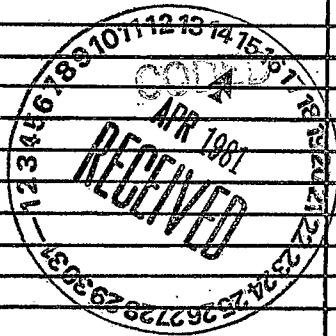

If well telescopes please sketch and show depths.

GROUND LEVEL

			X

SECTION 33

Please indicate well location X.

ADDITIONAL INFORMATION

If more than one screen,
show locations of each on sketch.