

Leflore  
E 78  
1-14-80

MISSISSIPPI  
 BOARD OF WATER COMMISSIONERS  
 416 North State Street  
 Jackson, Mississippi 39201

CODED

WATER WELL DRILLERS LOG

1/14 1980 Dyer Leflore  
 date well completed firm name county well located

LANDOWNER:  
HOBSON GARY  
S. Slater, MS.  
 (mailing address)


description of formations encountered	from	to
<u>Clay</u>	<u>0</u>	<u>28</u>
<u>Fine Sand</u>	<u>28</u>	<u>38</u>
<u>Sand</u>	<u>38</u>	<u>45</u>
<u>Sand + Gravel</u>	<u>45</u>	<u>108</u>

WELL LOCATION:  
 sec. 36 T. 21 N. R. 2 E.  
1 miles W of Slater  
 (distance) (direction) (nearest town)

WELL PURPOSE:  
 (home, irrigation, municipal, industrial)

- WELL COMPLETION DATA:
- (1) diameter (inches) 16"
  - (2) total depth (feet) 108'
  - (3) static water level (feet) 20' below above top of ground.
  - (4) casing Steel 108'  
 (material) (depth)  
16" if telescope see back.  
 (size)
  - (5) screen 40' 65'  
 (length) (depth to top)  
16" Steel  
 (size) (material)
  - (6) pump 60 3000  
 (HP) (yield gpm)  
Electric  
 (type power)
  - (7) electric log (yes or no) \_\_\_\_\_  
 (organization running log) \_\_\_\_\_
  - (8) how well bottom plugged plate

CODED

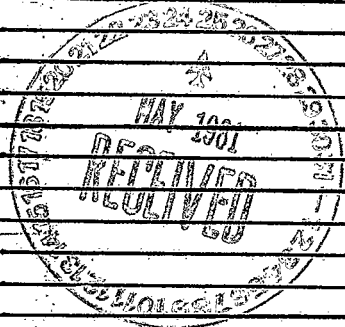

DRILLERS REMARKS:

If well telescopes please sketch and show depths.

GROUND LEVEL

	X		

SECTION 36

Please indicate well location X.

ADDITIONAL INFORMATION

If more than one screen,  
show locations of each on sketch.