

MISSISSIPPI DEPARTMENT OF NATURAL RESOURCES

Bureau of Land and Water Resources

Southport Mall

P.O. Box 10631

Jackson, Mississippi 39209

WATER WELL DRILLERS LOG

CODED

BUTANE GAS COMPANY

LeFlore

OF GREENWOOD

county well located

LeFlore
C.79
5-22-81

5-22 19 81
date well completed

LANDOWNER:	description of formations encountered	from	to
<u>Dewitt Corp.</u>	<u>CLAY</u>	<u>0</u>	<u>35</u>
<u>Greenwood</u> (mailing address)	<u>Sand + Gravel</u>	<u>35</u>	<u>98</u>
	<u>Rock</u>		

WELL LOCATION:
sec. 19 T 21 N R. 2 E
8 W
5.5 miles N.W. of Schulaten
(distance) (direction) (nearest town)

WELL PURPOSE: CATTLE
(home, irrigation, municipal, industrial)

- WELL COMPLETION DATA:
- (1) diameter (inches) 16"
 - (2) total depth (feet) 98'
 - (3) static water level (feet) 25 below above top of ground.
 - (4) casing Steel, 58,
(material) (depth)
16" if telescope see back.
(size)
 - (5) screen 40, 58
(length) (depth to top)
16, Steel
(size) (material)
 - (6) pump 60 2500
(HP) (yield gpm)
Diesel
(type power)
 - (7) electric log No
(yes or no)
- (organization running log)

CODED

(8) how well bottom plugged
Steel Plate

DRILLERS REMARKS:


DEPT. OF NATURAL RESOURCES
BUREAU OF LAND & WATER RESOURCES

MAY 28 1981

RECEIVED

If well telescopes please sketch and show depths.

GROUND LEVEL

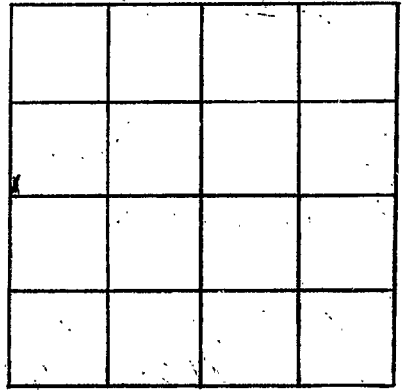

SECTION 19

Please indicate well location X.

ADDITIONAL INFORMATION

If more than one screen, show locations of each on sketch.