

MISSISSIPPI DEPARTMENT OF NATURAL RESOURCES

Bureau of Land and Water Resources

Southport Mall

P.O. Box 10631

Jackson, Mississippi 39209

WATER WELL DRILLERS LOG

CODED

Leflore
C 81
6-25-81

6-25 1981 BUTANE GAS COMPANY
 date well completed OF GREENWOOD

Leflore
 county well located

LANDOWNER:	description of formations encountered	from	to
<u>Dewitt Corp</u>	<u>Clay</u>	<u>0</u>	<u>32</u>
<u>Schuster, Mo.</u> (mailing address)	<u>Sand & gravel</u>	<u>32</u>	<u>50</u>
	<u>Sand & gravel</u>	<u>50</u>	<u>70</u>
	<u>Sand</u>	<u>70</u>	<u>80</u>
	<u>Clay</u>	<u>80</u>	<u>84</u>
WELL LOCATION:			
sec. <u>20</u> T <u>21</u> N, R <u>2</u> E			
<u>3</u> miles <u>NW</u> of <u>Schuster</u> (distance) (direction) (nearest town)			
WELL PURPOSE: <u>irrigation</u> (home, irrigation, municipal, industrial)			
WELL COMPLETION DATA:			
CODED			
(1) diameter (inches) <u>16"</u>			
(2) total depth (feet) <u>80</u>			
(3) static water level (feet) <u>25</u> <small>below above</small> top of ground.			
(4) casing <u>steel</u> , <u>40</u> (material) (depth)			
<u>16"</u> if telescope see back. (size)			
(5) screen <u>40</u> , <u>40</u> (length) (depth to top)			
<u>16"</u> , <u>steel</u> (size) (material)			
(6) pump <u>60</u> , <u>3000</u> (HP) (yield gpm)			
<u>Electric</u> (type power)			
(7) electric log _____ (yes or no)			
_____ (organization running log)			
(8) how well bottom plugged <u>Steel plate</u>			
DRILLERS REMARKS:			


DEPT. OF NATURAL RESOURCES
 BUREAU OF LAND & WATER RESOURCES

JUL - 2 1981

RECEIVED

If well telescopes please sketch and show depths.

GROUND LEVEL

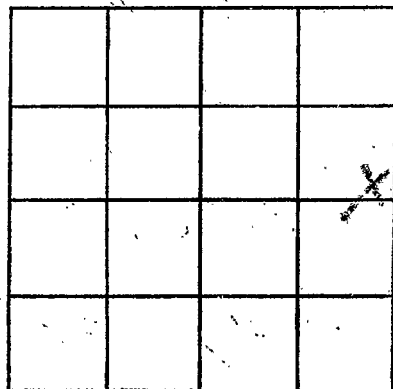

SECTION 20

Please indicate well location X.

ADDITIONAL INFORMATION

If more than one screen,
show locations of each on sketch.