

MISSISSIPPI DEPARTMENT OF NATURAL RESOURCES  
 Bureau of Land and Water Resources  
 Southport Mall  
 P.O. Box 10631  
 Jackson, Mississippi 39209  
**WATER WELL DRILLERS LOG**

**CODED**

LePore  
C 83  
6-17-81

6-17 19 81 BUTANE GAS COMPANY  
 date well completed OF GREENWOOD

LePore  
 county well located

LANDOWNER:  
Dewitt Corp.  
Schlater, Mo.  
 (mailing address)

description of formations encountered	from	to
<u>Clay</u>	<u>0</u>	<u>27</u>
<u>SAND</u>	<u>27</u>	<u>36</u>
<u>SAND + Gravel</u>	<u>36</u>	<u>89</u>
<u>Rock Clay</u>	<u>89</u>	<u>90</u>

WELL LOCATION:  
 sec. 19 T 24 N R. 2 E  
6 miles NW of Schlater  
 (distance) (direction) (nearest town)

WELL PURPOSE: irrigation  
 (home, irrigation, municipal, industrial)

- WELL COMPLETION DATA:
- (1) diameter (inches) 16"
  - (2) total depth (feet) 90
  - (3) static water level (feet) 25 <sup>below</sup> above top of ground.
  - (4) casing Steel, 50  
 (material) (depth)  
16" if telescope see back.  
 (size)
  - (5) screen 40', 50  
 (length) (depth to top)  
16", Steel  
 (size) (material)
  - (6) pump 60 2500  
 (HP) (yield gpm)  
Electric  
 (type power)
  - (7) electric log \_\_\_\_\_  
 (yes or no)  
 \_\_\_\_\_  
 (organization running log)
  - (8) how well bottom plugged Steel Plate

CODED

DEPT. OF NATURAL RESOURCES  
 BUREAU OF LAND & WATER RESOURCES


JUL - 2 1981

RECEIVED

DRILLERS REMARKS:

If well telescopes please sketch and show depths.

GROUND LEVEL

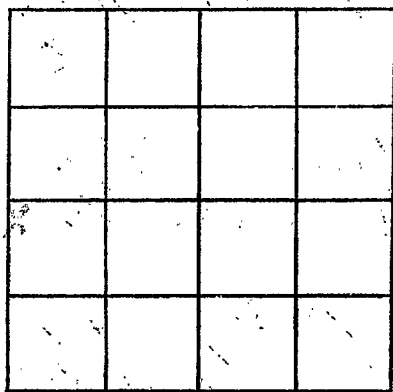

SECTION 19

Please indicate well location X.

ADDITIONAL INFORMATION

If more than one screen,  
show locations of each on sketch.