

MISSISSIPPI DEPARTMENT OF NATURAL RESOURCES

Bureau of Land and Water Resources

Southport Mall

P.O. Box 10631

**CODED**

Leflore  
C 84  
7-23-81

BUTANE GAS CO. OF GREENWOOD JACKSON, MISSISSIPPI 39209  
POST OFFICE BOX 1197  
WATER WELLS DRILLERS LOG  
GREENWOOD, MISS. 39930


7-23 1981  
date well completed

firm name

Leflore  
county well located

LANDOWNER:	description of formations encountered	from	to
<u>Dewalt Corp.</u>			
<u>Schluter, Mo</u> (mailing address)	<u>sand</u>	<u>24</u>	<u>30</u>
	<u>Sand &amp; P. Gravel</u>	<u>30</u>	<u>40</u>
	<u>Sand &amp; Gravel</u>	<u>40</u>	<u>50</u>
	<u>sand &amp; p. gravel</u>	<u>50</u>	<u>60</u>
	<u>sand &amp; gravel</u>	<u>60</u>	<u>97</u>
	<u>Clay</u>	<u>97</u>	
WELL LOCATION:			
sec. <u>34</u> T <u>21</u> N R <u>2</u> E W			
<u>4.5</u> miles <u>W</u> of <u>Schluter</u> (distance) (direction) (nearest town)			
WELL PURPOSE: <u>irrigation</u> (home, irrigation, municipal, industrial)			
WELL COMPLETION DATA:			
(1) diameter (inches) <u>16"</u>			
(2) total depth (feet) <u>97</u>			
(3) static water level (feet) <u>25</u> <input checked="" type="radio"/> below <input type="radio"/> above top of ground.			
(4) casing <u>steel</u> <u>57</u> (material) (depth)			
<u>16"</u> if telescope see back. (size)			
(5) screen <u>40'</u> <u>57</u> (length) (depth to top)			
<u>16"</u> <u>steel</u> (size) (material)			
(6) pump <u>60</u> <u>2500</u> (HP) (yield gpm)			
<u>Diesel</u> (type power)			
(7) electric log _____ (yes or no)			
(organization running log)			
(8) how well bottom plugged <u>steel plate</u>			


**CODED**

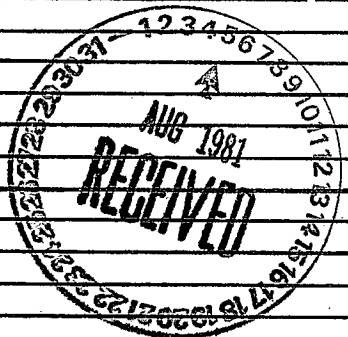

DRILLERS REMARKS:

If well telescopes please sketch and show depths.

GROUND LEVEL

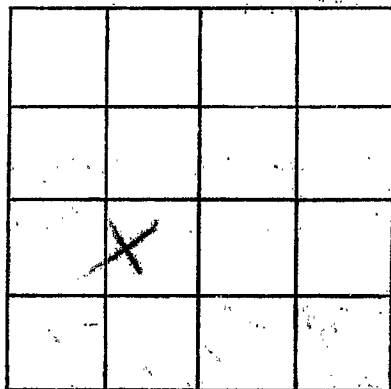

SECTION 53

Please indicate well location X.

ADDITIONAL INFORMATION

If more than one screen, show locations of each on sketch.