

MISSISSIPPI DEPARTMENT OF NATURAL RESOURCES

Bureau of Land and Water Resources

Southport Mall

P.O. Box 10631

Jackson, Mississippi 39209

POST OFFICE BOX 1135

GREENWOOD, MISS. 38930

CODED

*Leflore*  
 C 85  
 7-22-81

7-22 1981 date well completed *Leflore* firm name *Leflore* county well located

LANDOWNER:  
*Rowlett Corp*  
*Schlater Mrs*  
 (mailing address)

| description of formations encountered | from      | to        |
|---------------------------------------|-----------|-----------|
| <i>Clay</i>                           | <i>0</i>  | <i>28</i> |
| <i>fine sand</i>                      | <i>28</i> | <i>40</i> |
| <i>sand</i>                           | <i>40</i> | <i>50</i> |
| <i>sand &amp; p. gravel</i>           | <i>50</i> | <i>84</i> |
| <i>Rock</i>                           | <i>84</i> |           |

WELL LOCATION:  
 sec. *34* T. *21* N. R. *2* W.  
*4.5* miles *W* of *Schlater*  
 (distance) (direction) (nearest town)

WELL PURPOSE: *irrigation*  
 (home, irrigation, municipal, industrial)

WELL COMPLETION DATA:

(1) diameter (inches) *16"*

(2) total depth (feet) *84*

(3) static water level (feet) *20* (below/above top of ground)

(4) casing *steel*, *44* (material), (depth)

*16"* (size) if telescope see back.

(5) screen *40*, *44* (length), (depth to top)

*16"*, *steel* (size), (material)

(6) pump *60* (HP), *2500* (yield gpm)


*Piesel* (type power)

(7) electric log (yes or no)

(organization running log)

(8) how well bottom plugged *well mate*

CODED

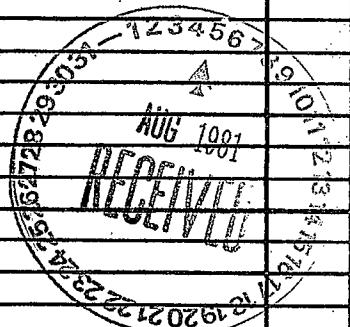

DRILLERS REMARKS:

If well telescopes please sketch and show depths.

GROUND LEVEL

|  |   |  |  |
|--|---|--|--|
|  |   |  |  |
|  | X |  |  |
|  |   |  |  |
|  |   |  |  |

SECTION 33

Please indicate well location X.

ADDITIONAL INFORMATION

If more than one screen,  
show locations of each on sketch.