

MISSISSIPPI DEPARTMENT OF NATURAL RESOURCES

Bureau of Land and Water Resources

Southport Mall

P. O. Box 10631

**CODED**

BUTANE GAS CO. OF GREENWOOD  
 JACKSON, MISSISSIPPI 39209  
 POST OFFICE BOX 1130  
 GREENWOOD, MISS. 38930  
 WATER WELL DRILLERS LOG

Leflore  
C 86  
7-18-81

7-18 1981 date well completed      Leflore firm name      Leflore county well located

LANDOWNER:  
Dewitt Corp.  
Schlater, Ms.  
 (mailing address)


description of formations encountered	from	to
<u>Clay</u>	<u>0</u>	<u>26</u>
<u>fine sand Brown shales</u>	<u>26</u>	<u>38</u>
<u>sand &amp; gravel</u>	<u>38</u>	<u>45</u>
<u>sand &amp; gravel</u>	<u>45</u>	<u>80</u>
<u>sand &amp; pea gravel</u>	<u>80</u>	<u>87</u>
<u>Rock clay</u>	<u>87</u>	

WELL LOCATION:  
 sec. 34 T 21 N R 2E  
4 miles W of Schlater  
 (distance) (direction) (nearest town)

WELL PURPOSE: Irrigation  
 (home, irrigation, municipal, industrial)

- WELL COMPLETION DATA:
- (1) diameter (inches) 16"
  - (2) total depth (feet) 87
  - (3) static water level (feet) 20 below top of ground.
  - (4) casing Steel 47 (material) (depth);  
16" (size) if telescope see back.
  - (5) screen 40 (length) 47 (depth to top);  
16" (size) Steel (material)
  - (6) pump 60 (HP) 2500 (yield gpm);  
Diesel (type power)
  - (7) electric log                      (yes or no)  
                     (organization running log)
  - (8) how well bottom plugged Steel plate

**CODED**

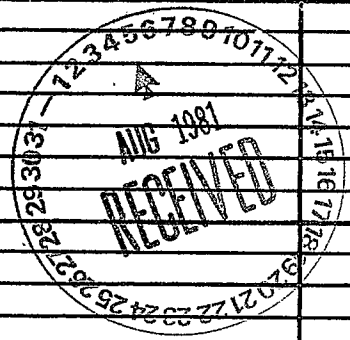

DRILLERS REMARKS:

If well telescopes please sketch and show depths.

GROUND LEVEL

X			

SECTION 24

Please indicate well location X.

ADDITIONAL INFORMATION

If more than one screen,  
show locations of each on sketch.