

MISSISSIPPI DEPARTMENT OF NATURAL RESOURCES

Bureau of Land and Water Resources

Southport Mall

P.O. Box 10631

Jackson, Mississippi 39209

BUTANE GAS WATER WELL DRILLERS LOG

POST OFFICE BOX 1136

GREENWOOD, MISS. 38930

COL

CODED

Leflore
C 87
7-16-81


7-16 1981 date well completed

firm name

Leflore county well located


LANDOWNER:	description of formations encountered	from	to
<i>Smith Corp</i>			
<i>Schlater, Mrs</i>	<i>Blue Clay</i>	10	20
(mailing address)	<i>Clay</i>	20	25
WELL LOCATION:	<i>Sand</i>	25	30
sec. <u>29</u> T <u>4</u> N R <u>2</u> E	<i>Sand clay mixed</i>	30	40
<u>4.5</u> miles <u>NW</u> of <u>Schlater</u>	<i>Sand & pea gravel</i>	40	58
(distance) (direction) (nearest town)	<i>Sand & gravel</i>	50	58
WELL PURPOSE:	<i>Sand & pea gravel</i>	77	80
(home, irrigation, municipal, industrial)	<i>Sand & gravel</i>	80	89
WELL COMPLETION DATA:	<i>Clay</i>	89	90
(1) diameter (inches) <u>16"</u>			
(2) total depth (feet) <u>90</u>			
(3) static water level (feet) <u>25</u> ^{below} / _{above} top of ground.			
(4) casing <u>Steel 50</u> (material) (depth)			
<u>16"</u> (size) if telescope see back.			
(5) screen <u>40'</u> <u>50</u> (length) (depth to top)			
<u>16"</u> (size) <u>Steel</u> (material)			
(6) pump <u>60</u> <u>2500</u> (HP) (yield gpm)			
<u>Direct</u> (type power)			
(7) electric log <u> </u> (yes or no)			
(organization running log)			
(8) how well bottom plugged <u>Steel plate</u>			
DRILLERS REMARKS:			

CODED

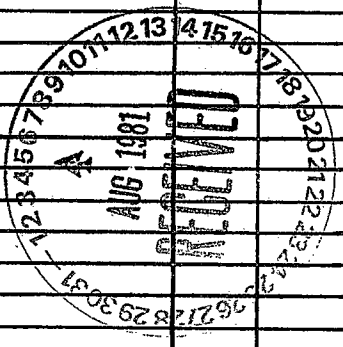

If well telescopes please sketch and show depths.

GROUND LEVEL

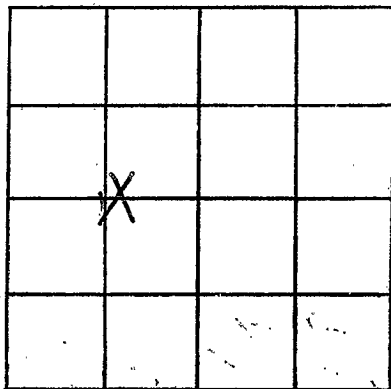

SECTION 26

Please indicate well location X.

ADDITIONAL INFORMATION

If more than one screen, show locations of each on sketch.