

MISSISSIPPI DEPARTMENT OF NATURAL RESOURCES

Bureau of Land and Water Resources

Southport Mall

P.O. Box 1063

Jackson, Mississippi 39209

WATER WELL DRILLERS LOG

**CODED**

Before  
C 88  
9-8-81

9-8 19 81 BUTANE GAS CO. OF GREENWOOD Before  
POST OFFICE BOX 8135  
GREENWOOD, MISS. 38920 county well located

LANDOWNER:	description of formations encountered	from	to
<u>Dewitt Corp.</u>	<u>CLAY</u>	<u>0</u>	<u>29</u>
<u>Schluter Mrs</u>	<u>SAND</u>	<u>29</u>	<u>54</u>
(mailing address)	<u>SAND + POA GRAVEL</u>	<u>54</u>	<u>70</u>
	<u>SAND - GRAVEL - ROCK</u>	<u>70</u>	<u>72</u>
	<u>SAND - GRAVEL ROCK UN</u>	<u>72</u>	<u>90</u>

WELL LOCATION:  
sec. 28 T 21 N R 2 E  
3 miles W of Schluter  
(distance) (direction) (nearest town)

WELL PURPOSE: IRRIGATION  
(home, irrigation, municipal, industrial)

- WELL COMPLETION DATA:
- (1) diameter (inches) 16"
  - (2) total depth (feet) 90
  - (3) static water level (feet) 30 below above  
top of ground.
  - (4) casing Steel 50  
(material) (depth)
  - 16"  
(size) if telescope see back.
  - (5) screen 40 50  
(length) (depth to top)
  - 16" Steel  
(size) (material)
  - (6) pump 60 2500  
(HP) (yield gpm)
  - Diesel  
(type power)
  - (7) electric log NO  
(yes or no)
  - (organization running log)
  - (8) how well bottom plugged Steel plate


DRILLERS REMARKS:  
EARLY

**CODED**

DEPT. OF NATURAL RESOURCES  
BUREAU OF LAND & WATER RESOURCES


SEP 18 1981

**RECEIVED**

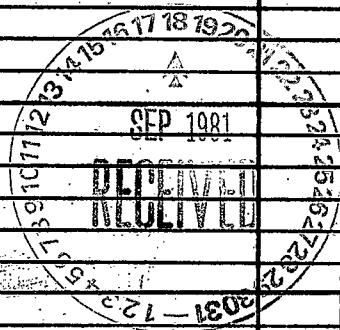

If well telescopes please sketch and show depths.

GROUND LEVEL

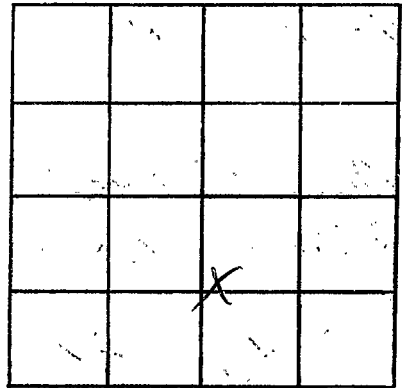

SECTION 28

Please indicate well location X.

ADDITIONAL INFORMATION

If more than one screen,  
show locations of each on sketch.