

MISSISSIPPI DEPARTMENT OF NATURAL RESOURCES

Bureau of Land and Water Resources

Southport Mall

P.O. Box 10631

Jackson, Mississippi 39209

WATER WELL DRILLERS LOG

**CODED**

BUTANE GAS CO. OF GREENWOOD

POST OFFICE BOX 1135

GREENWOOD, MISS. 38930

*Leflore*

*Leflore*  
*C 89*  
*8-27-81*

*8-27* 19 *81*  
date well completed


county well located

LANDOWNER:	description of formations encountered	from	to
<i>Dewitt Corp.</i>	<i>Clay</i>	<i>0</i>	<i>26</i>
<i>Schlater, Mo</i> (mailing address)	<i>fine sand + Clay</i>	<i>26</i>	<i>35</i>
WELL LOCATION:	<i>gravel</i>	<i>35</i>	<i>50</i>
sec <i>28</i> T <i>21</i> N R <i>2</i> E W	<i>sand + gravel</i>	<i>50</i>	<i>60</i>
<i>3</i> miles <i>W</i> of <i>Schlater</i> (distance) (direction) (nearest town)	<i>sand + p. gravel</i>	<i>60</i>	<i>73</i>
WELL PURPOSE: <i>irrigation</i> (home, irrigation, municipal, industrial)	<i>sand + gravel</i>	<i>73</i>	<i>79</i>
WELL COMPLETION DATA:	<i>sand</i>	<i>79</i>	<i>80</i>
(1) diameter (inches) <i>16"</i>	<i>sand + gravel</i>	<i>80</i>	<i>90</i>
(2) total depth (feet) <i>91'</i>	<i>Rock Clay</i>	<i>90</i>	<i>91</i>
(3) static water level (feet) <i>25</i> below top of ground.			
(4) casing <i>Steel</i> , <i>51'</i> (material) (depth)			
<i>16"</i> If telescope see back. (size)			
(5) screen <i>40'</i> , <i>51'</i> (length) (depth to top)			
<i>16"</i> , <i>Steel</i> (size) (material)			
(6) pump <i>60</i> , <i>280</i> (HP) (yield gpm)			
<i>Diesel</i> (type power)			
(7) electric log <i>NO</i> (yes or no)			
(organization running log)			
(8) how well bottom plugged <i>Steel plate</i>			
DRILLERS REMARKS: <i>Earl</i>			

DEPT. OF NATURAL RESOURCES  
BUREAU OF LAND & WATER RESOURCES

SEP 18 1981

**RECEIVED**

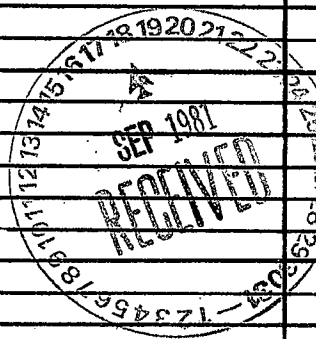

If well telescopes please sketch and show depths.

GROUND LEVEL

		X	

SECTION 28

Please indicate well location X.

ADDITIONAL INFORMATION

If more than one screen, show locations of each on sketch.