

MISSISSIPPI DEPARTMENT OF NATURAL RESOURCES

Bureau of Land and Water Resources

Southport Mall

P.O. Box 10631

Jackson, Mississippi 39209

WATER WELL DRILLERS LOG

CODED

BUTANE GAS CO. OF GREENWOOD

POST OFFICE BOX 4435

GREENWOOD, MISS. 38930

Leflore

date well completed

county well located

Leflore
C90
8-25-81

8-25 19 *81*

LANDOWNER:

Dewitt's Plant.

Schlater, Ms

(mailing address)

description of formations encountered

from

to

Clay

0 29

SAND & Pea Gravel

29 64

SAND & Gravel

64 90

Rock

90

WELL LOCATION:

sec. *24* T *21* N R. *2* E

3 miles *NW* of *Schlater*

(distance) (direction) (nearest town)

CODED

WELL PURPOSE: *IRRIGATION*
(home, irrigation, municipal, industrial)

WELL COMPLETION DATA:

- (1) diameter (inches) *16"*
- (2) total depth (feet) *90'*
- (3) static water level (feet) *25* ^{below} _{above} top of ground.

- (4) casing *Steel*, *50*
(material) (depth)
- 16"*
(size) if telescope see back.

- (5) screen *40'*, *50*
(length) (depth to top)

- 16"*, *steel*
(size) (material)

- (6) pump *60*, *2500*
(HP) (yield gpm)

- Diesel*
(type power)

- (7) electric log *No*
(yes or no)

(organization running log)


- (8) how well bottom plugged
Steel plate

DRILLERS REMARKS: *Encl*

DEPT. OF NATURAL RESOURCES
BUREAU OF LAND & WATER RESOURCES

SEP 18 1981

RECEIVED

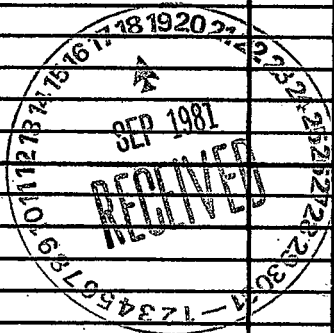

If well telescopes please sketch and show depths.

GROUND LEVEL

| | | | |
|--|--|--|--|
| | | | |
| | | | |
| | | | |
| | | | |

SECTION 28

Please indicate well location X.

ADDITIONAL INFORMATION

If more than one screen, show locations of each on sketch.