

MISSISSIPPI DEPARTMENT OF NATURAL RESOURCES  
 Bureau of Land and Water Resources  
 Southport Mall  
 P.O. Box 10631  
 Jackson, Mississippi 39209  
**WATER WELL DRILLERS LOG**

**CODED.**

Leflore  
C 94  
10-6-81

10-6 1981 M.C. Tillman Leflore  
 date well completed firm name county well located

LANDOWNER: M.C. Tillman

description of formations encountered	from	to

(mailing address)

WELL LOCATION:

sec. 13 T. 21 N. R. 2 E.  
3 miles N of Schlater  
 (distance) (direction) (nearest town)

<u>Clay</u>	<u>0</u>	<u>30</u>
<u>Fine Sand</u>	<u>30</u>	<u>40</u>
<u>Sand + Gravel</u>	<u>40</u>	<u>76</u>
<u>Fine Sand</u>	<u>76</u>	<u>84</u>
<u>Sand + Gravel</u>	<u>84</u>	<u>106</u>

WELL PURPOSE:  
 (home, irrigation, municipal, industrial)

WELL COMPLETION DATA:

- (1) diameter (inches) 16
- (2) total depth (feet) 106
- (3) static water level (feet) 22 below above top of ground.
- (4) casing Steel, 66,  
 (material) (depth)  
16 If telescope see back.  
 (size)
- (5) screen 40, 66  
 (length) (depth to top)  
16, Mild Steel  
 (size) (material)
- (6) pump 40 2000  
 (HP) (yield gpm)  
Diesel  
 (type power)
- (7) electric log No  
 (yes or no)  
None  
 (organization running log)
- (8) how well bottom plugged Plate

**CODED.**

DEPT. OF NATURAL RESOURCES  
 BUREAU OF LAND & WATER RESOURCES


NOV 6 - 1981

DRILLERS REMARKS:

**RECEIVED**

If well telescopes please sketch and show depths.

GROUND LEVEL

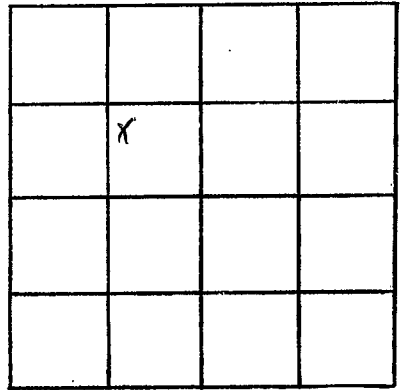

SECTION 13

Please indicate well location X.

ADDITIONAL INFORMATION

If more than one screen,  
show locations of each on sketch.