

MISSISSIPPI DEPARTMENT OF NATURAL RESOURCES

Bureau of Land and Water Resources

Southport Mall

P.O. Box 10631

CODED

Jackson, Mississippi 39209

WATER WELL DRILLERS' LOG

Leffore
C 95

8-21 1981 OVER WELL + Irrigation Leffore
date well completed firm name county well located

LANDOWNER: <u>W.E. PALMERDRES</u> (mailing address)	description of formations encountered	from	to
WELL LOCATION: sec. <u>34</u> T <u>21</u> (N) R <u>2</u> E S (W) <u>6</u> miles <u>DW</u> of <u>Miller cit</u> (distance) (direction) (nearest town)	Clay	0	28
WELL PURPOSE: <u>Irrigation</u> (home, irrigation, municipal, industrial)	find sand	28	35
WELL COMPLETION DATA: (1) diameter (inches) <u>16"</u> (2) total depth (feet) <u>100</u> (3) static water level (feet) <u>21</u> below/above top of ground. (4) casing <u>Steel</u> , <u>60</u> , (material) (depth) <u>16"</u> If telescope see back. (size) (5) screen <u>40'</u> , <u>60'</u> , (length) (depth to top) <u>16"</u> , <u>Mild Steel</u> (size) (material) (6) pump <u>60</u> - <u>3000</u> (HP) (yield gpm) <u>Diesel</u> (type power) (7) electric log <u>No</u> (yes or no) <u>None</u> (organization running log) (8) how well bottom plugged <u>Plate</u>	Sand + Gravel 35 100		

DEPT. OF NATURAL RESOURCES
BUREAU OF LAND & WATER RESOURCES


MAY 14 1982

RECEIVED

DRILLERS REMARKS:

If well telescopes please sketch and show depths.

GROUND LEVEL

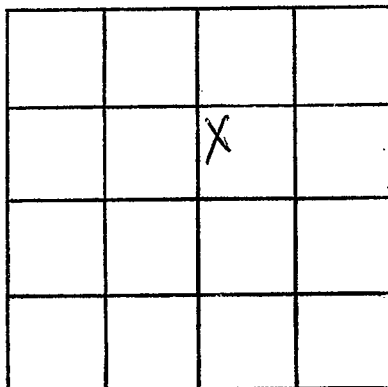

SECTION 4

Please indicate well location X.

ADDITIONAL INFORMATION

If more than one screen, show locations of each on sketch.