

MISSISSIPPI DEPARTMENT OF NATURAL RESOURCES
Bureau of Land and Water Resources
 Southport Mall
 P.O. Box 10631
 Jackson, Mississippi 39209
WATER WELL DRILLERS LOG

CODED

Refuse
~~07-21-82~~
 96

6-24 1982 *Layne-Central Co.* *Refuse*
 date well completed firm name county well located

LANDOWNER:	description of formations encountered	from	to
<i>Dewitt Corporation</i>			
<i>Greenwood, Ms</i> (mailing address)	<i>coarse sand</i>	<i>24</i>	<i>48</i>
	<i>coarse sand & pea gravel</i>	<i>48</i>	<i>85</i>
	<i>coarse sand & gravel</i>	<i>85</i>	<i>101</i>
	<i>Clay</i>	<i>101</i>	<i>102</i>
WELL LOCATION: # 2			
sec. <i>33</i> T <i>21</i> (N) R <i>2</i> E S (W)			
<i>4</i> miles <i>West</i> of <i>Chataway</i> (distance) (direction) (nearest town)			
WELL PURPOSE: (home, irrigation, municipal, industrial)			
WELL COMPLETION DATA:			
(1) diameter (inches) <i>20"</i>			
(2) total depth (feet) <i>98'</i>			
(3) static water level (feet) <i>28'</i> below top of ground.			
(4) casing <i>PVC</i> , <i>58'</i> (material), (depth)			
<i>8"</i> (size) if telescope see back.			
(5) screen <i>40'</i> , <i>58'</i> (length), (depth to top)			
<i>8"</i> , <i>PVC</i> (size), (material)			
(6) pump <i>7.5</i> , <i>300</i> (HP), (yield gpm)			
<i>electric</i> (type power)			
(7) electric log <i>no</i> (yes or no)			
(organization running log)			
(8) how well bottom plugged <i>cap</i>			
DRILLERS REMARKS:			


DEPT. OF NATURAL RESOURCES
 BUREAU OF LAND & WATER RESOURCES

DEC - 6 1982

RECEIVED

If well telescopes please sketch and show depths.

GROUND LEVEL

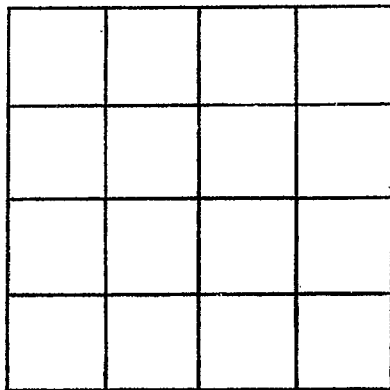

SECTION _____

Please indicate well location X.

ADDITIONAL INFORMATION

If more than one screen,
show locations of each on sketch.