

Lefflore
~~CE 2242~~
297

MISSISSIPPI DEPARTMENT OF NATURAL RESOURCES
 Bureau of Land and Water Resources
 Southport Mall
 P.O. Box 10631
 Jackson, Mississippi 39209
WATER WELL DRILLERS LOG (CODED)

7-22 1982 Lefflore-Central Co. Lefflore
 date well completed firm name county well located

LANDOWNER:
Newitt Corporation
Greenwood, Ms
 (mailing address)
 WELL LOCATION: #1
 sec. 34 T 21 (N) R 2 E
B miles W of Schlater
 (distance) (direction) (nearest town)

description of formations encountered	from	to
<u>clay</u>	<u>0</u>	<u>19</u>
<u>fine sand</u>	<u>19</u>	<u>38</u>
<u>coarse sand</u>	<u>38</u>	<u>56</u>
<u>coarse sand & gravel</u>	<u>56</u>	<u>75</u>
<u>coarse sand & per gravel</u>	<u>75</u>	<u>90</u>
<u>coarse sand & gravel</u>	<u>90</u>	<u>101</u>
<u>clay</u>	<u>101</u>	<u>103</u>

WELL PURPOSE:
 (home, irrigation, municipal, industrial)
irrigation

WELL COMPLETION DATA:
 (1) diameter (inches) 32"
 (2) total depth (feet) 101'
 (3) static water level (feet) 38' below above top of ground.
 (4) casing steel, 61'
 (material) (depth)
16" if telescope see back.
 (size)
 (5) screen 40', 61'
 (length) (depth to top)
16", steel
 (size) (material)
 (6) pump 60 2200
 (HP) (yield gpm)
electric
 (type power)
 (7) electric log no
 (yes or no)
 (organization running log)
 (8) how well bottom plugged plate

DEPT. OF NATURAL RESOURCES
 BUREAU OF LAND & WATER RESOURCES


DEC - 6 1982

RECEIVED

DRILLERS REMARKS:

If well telescopes please sketch and show depths.

GROUND LEVEL

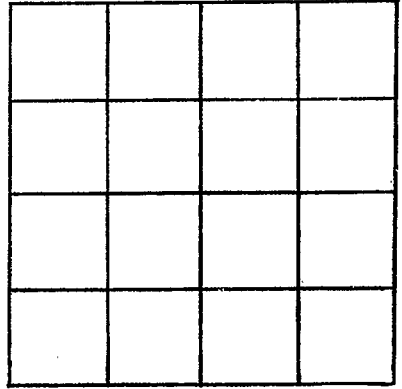

SECTION _____

Please indicate well location X.

ADDITIONAL INFORMATION

If more than one screen,
show locations of each on sketch.