

*Leflore*  
*C-2242*  
*C 98*

MISSISSIPPI DEPARTMENT OF NATURAL RESOURCES  
 Bureau of Land and Water Resources  
 Southport Mall  
 P.O. Box 10631  
 Jackson, Mississippi 39209  
**WATER WELL DRILLERS LOG**

**CODED**

7-27 1982 *Layne-Central Co.* *Leflore*  
 date well completed firm name county well located

LANDOWNER:  
*Dewitt Corporation*  
*Greenwood, Ms*  
 (mailing address)

description of formations encountered	from	to
<i>clay</i>	<i>0</i>	<i>26</i>
<i>fine sand</i>	<i>26</i>	<i>35</i>
<i>coarse sand</i>	<i>35</i>	<i>43</i>
<i>coarse sand &amp; gravel</i>	<i>43</i>	<i>74</i>
<i>coarse sand &amp; fine gravel</i>	<i>74</i>	<i>87</i>
<i>coarse sand &amp; gravel</i>	<i>87</i>	<i>103</i>

WELL LOCATION: #2  
 sec. *34*-T *21*(N) S R. *2* E *W*  
*8* miles *W* of *Leflore*  
 (distance) (direction) (nearest town)

WELL PURPOSE:  
 (home, irrigation, municipal, industrial)

- WELL COMPLETION DATA:
- (1) diameter (inches) *32"*
  - (2) total depth (feet) *103'*
  - (3) static water level (feet) *41'* below above top of ground.
  - (4) casing *steel*, *63'*  
 (material) (depth)  
*16"* if telescope see back.  
 (size)
  - (5) screen *40'*, *63'*  
 (length) (depth to top)  
*16"*, *steel*  
 (size) (material)
  - (6) pump *60*, *2200*  
 (HP) (yield gpm)  
*electric*  
 (type power)
  - (7) electric log *no*  
 (yes or no)  
 (organization running log)
  - (8) how well bottom plugged *plate*

DEPT OF NATURAL RESOURCES  
 BUREAU OF LAND & WATER RESOURCES


DEC - 6 1982

**RECEIVED**

DRILLERS REMARKS:

If well telescopes please sketch and show depths.

GROUND LEVEL

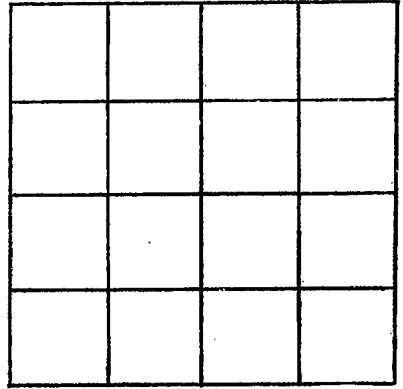

SECTION \_\_\_\_\_

Please indicate well location X.

ADDITIONAL INFORMATION

If more than one screen,  
show locations of each on sketch.