

MISSISSIPPI DEPARTMENT OF NATURAL RESOURCES

Bureau of Land and Water Resources

Southport Mall

P.O. Box 10631

Jackson, Mississippi 39209

WATER WELL DRILLERS LOG

CODED

Leffore  
C99

19 1983 date well completed Dyer, Wells & Sons firm name Leffore county well located

LANDOWNER: <u>M.C. Silman</u>	description of formations encountered	from	to
(mailing address)	<u>Clay</u>	<u>0</u>	<u>36</u>
WELL LOCATION: sec. <u>5</u> T <u>21</u> N R <u>2</u> E <u>5</u> miles <u>SW</u> of <u>Sunnyvale</u> (distance) (direction) (nearest town)	<u>Sand</u>	<u>36</u>	<u>40</u>
WELL PURPOSE: (home, irrigation, municipal, industrial)	<u>Sand &amp; Gravel</u>	<u>40</u>	<u>103</u>
WELL COMPLETION DATA:			
(1) diameter (inches) <u>12"</u>			
(2) total depth (feet) <u>103</u>			
(3) static water level (feet) <u>15</u> below above top of ground.			
(4) casing <u>PVC</u> , <u>63</u> (material) (depth)			
(size) if telescope see back.			
(5) screen <u>40'</u> , <u>40'</u> (length) (depth to top)			
(size) <u>12"</u> , <u>PVC</u> (material)			
(6) pump <u>30'</u> , <u>1500</u> (HP) (yield gpm)			
(type power) <u>diesel</u>			
(7) electric log <u>no</u> (yes or no)			
(organization running log) <u>no</u>			
(8) how well bottom plugged <u>Cap</u>			
DRILLERS REMARKS:			


DEPT. OF NATURAL RESOURCES  
BUREAU OF LAND & WATER RESOURCES

FEB - 3 1983

RECEIVED

If well telescopes please sketch and show depths.

GROUND LEVEL

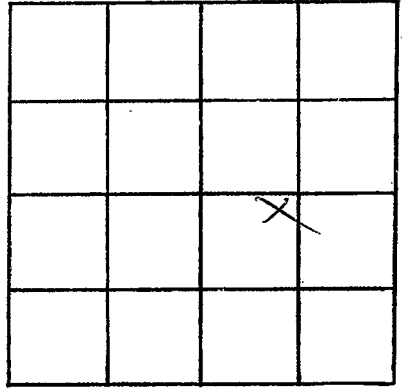

SECTION 5

Please indicate well location X.

ADDITIONAL INFORMATION

If more than one screen,  
show locations of each on sketch.