

MISSISSIPPI DEPARTMENT OF NATURAL RESOURCES

Bureau of Land and Water Resources

Southport Mall

P.O. Box 10631

Jackson, Mississippi 39209

WATER WELL DRILLERS LOG

CODED

Leflore
A C101
5-28-85

May 28 19 85
 date well completed

Bruce Berryman

Leflore

Greenwood, MS 38950. firm name county well located

LANDOWNER: Dudley Pillow
Rt. 1. Schlater,
MS 38952
 (mailing address)

WELL LOCATION:
 sec 34 T 21 N R — E
 S 2 W
2 miles West of Schlater
 (distance) (direction) (nearest town)

WELL PURPOSE: Home
 (home, irrigation, municipal, industrial)

WELL COMPLETION DATA:
 (1) diameter (inches) 4" x 2"
 (2) total depth (feet) 1127 ft.
 (3) static water level (feet) Flow ^{below} top of ground.
4" blk - 126 ft.
 (4) casing 2" galv. -971 ft
 (material) (depth)

— If telescope see back.
 (size)
 (S) SCREEN 30 ft., 1097'
 (length) (depth to top)
2" .010 ga. Stainless steel
 (size) (material)

(6) pump 2 h.p.
 (HP) (yield gpm)
Electric
 (type power)
 (7) electric log Yes
 (yes or no)

Ms. Bureau of Geology.
 (organization running log)

(8) how well bottom plugged B.P.V.

DRILLERS REMARKS:

description of formations encountered	from	to
Clay	0	30
Sand & gravel	30	120
Rock	120	
Sand	120	200
Clay	200	220
Clay & rock	220	240
Clay	240	260
Sand	260	380
Shale	380	400
Sand	400	500
Clay	500	540
Shale & rock	540	560
Fine green sand	560	620
Green sand	620	680
Shale & rocks	680	740
Fine brown sand & rock	740	800
Shale	800	840
Brown sand & shale	840	880
Shale	880	960
Red sand & str shale	960	1000
Shale	1000	1080
White sand	1080	1160


RECEIVED

DEC 1 0 1985

Department of Natural Resources
 Bureau of Land & Water Resources

If well telescopes please sketch and show depths.

GROUND LEVEL

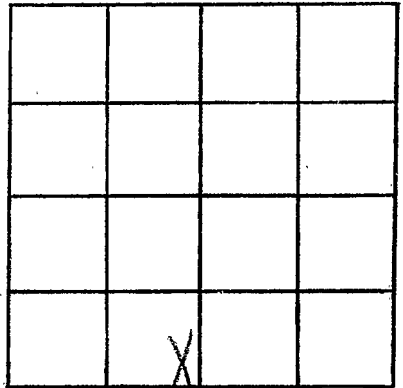

SECTION 34

Please indicate well location X.

ADDITIONAL INFORMATION

If more than one screen,
show locations of each on sketch.