

MISSISSIPPI DEPARTMENT OF NATURAL RESOURCES

Bureau of Land and Water Resources

Southport Mall

P.O. Box 10631

Jackson, Mississippi 39209

WATER WELL DRILLERS LOG

BUTANE GAS CO. OF GREENWOOD

CODED

LEFLORE  
C 104

5-9 1986  
date well completed

firm name

Le Flore  
county well located

LANDOWNER:  
Travelers, Inc.  
Greenwood, Miss.  
(mailing address)

description of formations encountered	from	to
<u>CLAY</u>	<u>0</u>	<u>35</u>
<u>Fine Sand</u>	<u>35</u>	<u>50</u>
<u>Big Sand + gravel</u>	<u>50</u>	<u>95</u>

WELL LOCATION:  
sec. 20 T 21 N R. 2 E  
SP W  
4 miles NW of Suh Lake  
(distance) (direction) (nearest town)

CODED


WELL PURPOSE: IND.  
(home, irrigation, municipal, industrial)

WELL COMPLETION DATA:

(1) diameter (inches) 16"  
(2) total depth (feet) 95'  
(3) static water level (feet) 74' below above top of ground.  
(4) casing Steel, 55',  
(material) (depth)  
16" if telescope see back.  
(size)  
(5) screen 40', 55'  
(length) (depth to top)  
16", Steel  
(size) (material)  
(6) pump 40 2,000  
(HP) (yield gpm)  
Elec.  
(type power)  
(7) electric log NO  
(yes or no)  
(organization running log)  
(8) how well bottom plugged  
Steel Plate

Permit #  
MSGW02953


DRILLERS REMARKS:

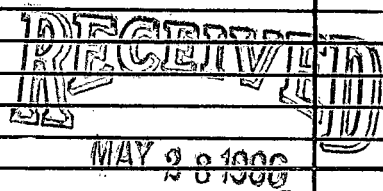

Department of Natural Resources  
Bureau of Land & Water Resources

If well telescopes please sketch and show depths.

GROUND LEVEL

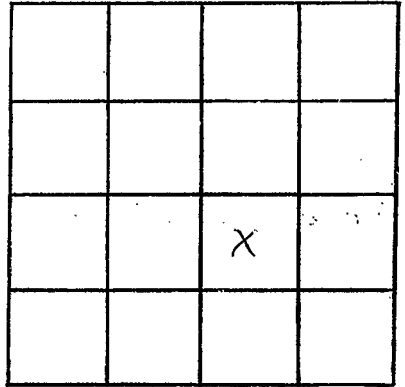

SECTION 20

Please indicate well location X.

ADDITIONAL INFORMATION

If more than one screen,  
show locations of each on sketch.