

MISSISSIPPI DEPARTMENT OF NATURAL RESOURCES

Bureau of Land and Water Resources

Southport Mall

P.O. Box 10631

Jackson, Mississippi 39209

WATER WELL DRILLERS LOG

CODED

LETLORE
C 106

5-21-86 date well completed 19 86 BUTANE GAS CO. OF GREENWOOD Letlore firm name county well located

LANDOWNER: AS
Travelers Inn.
Greenwood, Miss.
(mailing address)

description of formations encountered	from	to
<u>Clay</u>	<u>0</u>	<u>35</u>
<u>fine sand</u>	<u>35</u>	<u>50</u>
<u>Coarse & pea gravel</u>	<u>50</u>	<u>80</u>
<u>gravel</u>	<u>80</u>	<u>103</u>

WELL LOCATION:
sec. 9 T 21 N R 2 E
S W
5 miles NW of Water
(distance) (direction) (nearest town)

WELL PURPOSE: IR
(home, irrigation, municipal, industrial)

WELL COMPLETION DATA:

(1) diameter (inches) 16"

(2) total depth (feet) 103'

(3) static water level (feet) 23 below above top of ground.

(4) casing Steel, 63',
(material) (depth)
16" if telescope see back.
(size)

(5) screen 40', 63'
(length) (depth to top)
16", Steel
(size) (material)

(6) pump 40 2000
(HP) (yield gpm)
Elec.
(type power)


(7) electric log no
(yes or no)
(organization running log)

Permit #
MS61102956

CODED

(8) how well bottom plugged
Steel Plate

DRILLERS REMARKS:

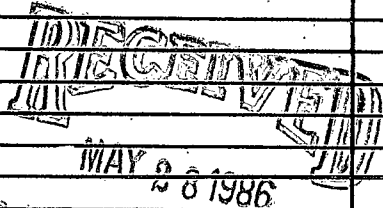

Department of Natural Resources
Bureau of Land & Water Resources

If well telescopes please sketch and show depths.

GROUND LEVEL

X			

SECTION 7

Please indicate well location X.

ADDITIONAL INFORMATION

If more than one screen,
show locations of each on sketch.