

LEFLORE
C107

MISSISSIPPI DEPARTMENT OF NATURAL RESOURCES
Bureau of Land and Water Resources
Southport Mall
P.O. Box 10631
Jackson, Mississippi 39209
WATER WELL DRILLERS LOG

CODED

7-8 1986 BUTANE GAS CO. OF GREENWOOD Leflore
date well completed firm name county well located

LANDOWNER:
TRAVELERS INS. Co.
Greenwood
(mailing address)

description of formations encountered	from	to
<u>CLAY</u>	<u>0</u>	<u>25</u>
<u>FINE SAND</u>	<u>25</u>	<u>50</u>
<u>SAND + PEA GRAVEL</u>	<u>50</u>	<u>75</u>
<u>GRAVEL</u>	<u>75</u>	<u>100</u>

WELL LOCATION:
sec. 21 T 21 N R 2 E
4 miles SW of SILVER
(distance) (direction) (nearest town)

WELL PURPOSE: IR.
(home, irrigation, municipal, industrial)

WELL COMPLETION DATA:

(1) diameter (inches) 16"

(2) total depth (feet) 100

(3) static water level (feet) 23 below top of ground.

(4) casing Steel, 60,
(material) (depth)
16" if telescope see back.
(size)


(5) screen 40, 60
(length) (depth to top)
16", Steel
(size) (material)

(6) pump 40 2000
(HP) (yield gpm)
Elec.
(type power)

(7) electric log No
(yes or no)
(organization running log)

Permit No.
MS-GW-02946

CODED

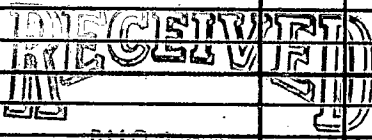

AUG 12 1986

Department of Natural Resources
Bureau of Land & Water Resources

(8) how well bottom plugged:
Steel plug

DRILLERS REMARKS:

If well telescopes please sketch and show depths.

GROUND LEVEL

X			

SECTION 21

Please indicate well location X.

ADDITIONAL INFORMATION

If more than one screen, show locations of each on sketch.