

MISSISSIPPI DEPARTMENT OF NATURAL RESOURCES

Bureau of Land and Water Resources

Southport Mall

P.O. Box 10631

Jackson, Mississippi 39209

WATER WELL DRILLERS LOG

CODED

LEFLORE
C108

7-12
date well completed

BUTANE GAS CO. OF GREENWOOD
firm name

LeFlore
county well located

LANDOWNER:
Travelers Ins. Co.
Greenwood
(mailing address)

description of formations encountered	from	to
<u>Clay</u>	<u>0</u>	<u>25</u>
<u>FINE SAND</u>	<u>25</u>	<u>40</u>
<u>SAND & PEA GRAVEL</u>	<u>40</u>	<u>70</u>
<u>GRAVEL</u>	<u>70</u>	<u>100</u>

WELL LOCATION:
sec. 21 T 24 N R 2 E
44 miles SW of Schlater
(distance) (direction) (nearest town)

WELL PURPOSE:
(home, irrigation, municipal, industrial)


WELL COMPLETION DATA:

- (1) diameter (inches) 16"
- (2) total depth (feet) 100
- (3) static water level (feet) 20 below above top of ground.
- (4) casing Steel, 60,
(material) (depth),
16" if telescope see back.
(size)
- (5) screen 40, 60
(length) (depth to top)
16", Steel
(size) (material)
- (6) pump 40 2000
(HP) (yield gpm)
Elec
(type power)
- (7) electric log No
(yes or no)

(organization running log)
- (8) how well bottom plugged Steel Plate

Permit No
M5-GW-02948

CODED

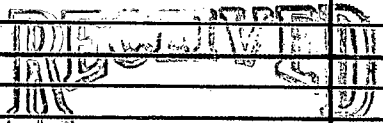


AUG 12 1986

Department of Natural Resources
Bureau of Land & Water Resources

DRILLERS REMARKS:

If well telescopes please sketch and show depths.

GROUND LEVEL

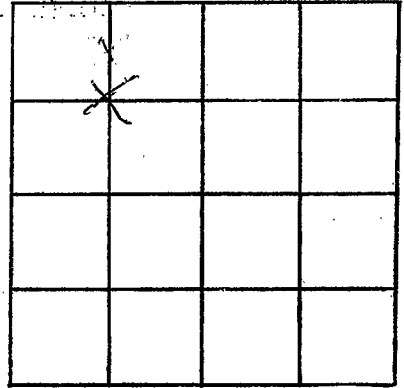

SECTION 27

Please indicate well location X.

ADDITIONAL INFORMATION

If more than one screen, show locations of each on sketch.