

LEFLORE
C 110

MISSISSIPPI DEPARTMENT OF NATURAL RESOURCES
 Bureau of Land and Water Resources
 Southport Mall
 P.O. Box 10631
 Jackson, Mississippi 39209
WATER WELL DRILLERS LOG

CODED

9-13-86
 date well completed

Butner Gas Co. of Greenwood
 firm name

Leflore
 county well located

LANDOWNER:
Trawlers, Inc.
Greenwood, Miss
 (mailing address)

description of formations encountered	from	to
<u>CLAY</u>	<u>0</u>	<u>25</u>
<u>Fine sand</u>	<u>25</u>	<u>60</u>
<u>sand gravel</u>	<u>60</u>	<u>80</u>
<u>FINE SAND</u>	<u>80</u>	<u>92</u>
<u>Sand gravel st.</u>	<u>92</u>	<u>100</u>

WELL LOCATION:
 sec 21 T 21 N R 2 E
 S W
3 1/4 miles NW of Schlater
 (distance) (direction) (nearest town)

CODED

WELL PURPOSE:
 (home, irrigation, municipal, industrial)

Permit #

WELL COMPLETION DATA:

MS-GW-02947

(1) diameter (inches) 16"
 (2) total depth (feet) 100

(3) static water level (feet) 20 ^{below} ~~above~~ top of ground.

(4) casing Steel, 60'
 (material) (depth)
16" if telescope see back.
 (size)

(5) screen 40' 60'
 (length) (depth to top)
16", Steel
 (size) (material)

(6) pump 40 2000
 (HP) (yield gpm)
Elect.
 (type power)

(7) electric log No
 (yes or no)
 (organization running log)

(8) how well bottom plugged
Steel plate


DRILLERS REMARKS:

RECEIVED
 SEP 20 1986

Department of Natural Resources
 Bureau of Land & Water Resources

If well telescopes please sketch and show depths.

GROUND LEVEL

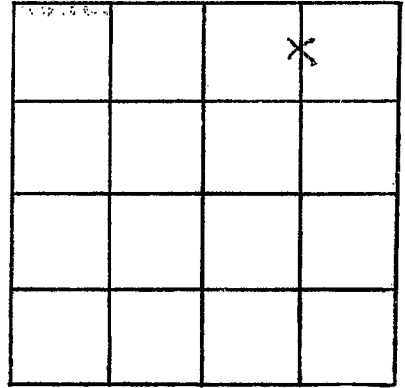

SECTION 21

Please indicate well location X.

ADDITIONAL INFORMATION

If more than one screen, show locations of each on sketch.