

MISSISSIPPI DEPARTMENT OF NATURAL RESOURCES

Bureau of Land and Water Resources

Southport Mall

P.O. Box 10631

Jackson, Mississippi 39209

WATER WELL DRILLERS LOG

LEFLORE
C III

8-15
date well completed

1986 BUTANE GAS CO. OF GREENWOOD
firm name

Leflore
county well located

LANDOWNER:
Trambers Ins.

(mailing address)

description of formations encountered	from	to
Clay	0	20
Fine Sand	20	55
Sand & grav.	55	80
grav.	80	90
Rock	90	

WELL LOCATION:
sec. 21 T 21 N R 2 E
W
3 1/2 miles NW of Schlater
(distance) (direction) (nearest town)

WELL PURPOSE:
(home, irrigation, municipal, industrial)

WELL COMPLETION DATA:

(1) diameter (inches) 8"

(2) total depth (feet) 90

(3) static water level (feet) below top of ground.

(4) casing: PVC, 50'
(material) (depth)
8" if telescope see back.
(size)

(5) screen 40', 50'
(length) (depth to top)
8", PVC
(size) (material)

(6) pump 10 HP, 500
(HP) (yield gpm)
Elec
(type power)

(7) electric log No
(yes or no)
(organization running log)

(8) how well bottom plugged PVC CAP

Permit #
MS-GW-05012


NOV 18 1986

Department of Natural Resources
Bureau of Land & Water Resources

DRILLERS REMARKS:

If well telescopes please sketch and show depths.

GROUND LEVEL

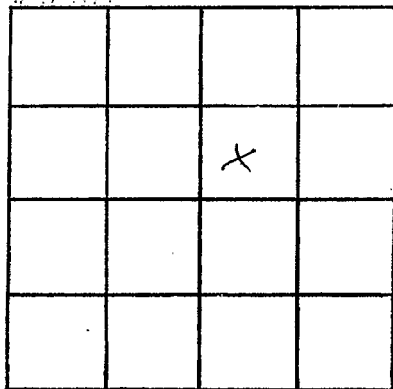

SECTION 21

Please indicate well location X.

ADDITIONAL INFORMATION

If more than one screen, show locations of each on sketch.