

MISSISSIPPI DEPARTMENT OF NATURAL RESOURCES

Bureau of Land and Water Resources

Southport Mall

P.O. Box 10631

Jackson, Mississippi 39209

WATER WELL DRILLERS LOG

CODED

LEFLORE
C112

5
date well completed

1987 J & K
firm name

LeFlore
county well located

LANDOWNER: W. M. JENNINS

description of formations encountered

from to

Po Box 192

Clay

0 31

SCHATTIE, MISS
(mailing address)

Fine sand

31 46

Coarse sand & gravel

46 119

WELL LOCATION:

sec 35 T 21 N R 12 E
S W
2 miles W of Schattie
(distance) (direction) (nearest town)

WELL PURPOSE: Domestic
(home, irrigation, municipal, industrial)

WELL COMPLETION DATA:

- (1) diameter (inches) 10"
- (2) total depth (feet) 117
- (3) static water level (feet) 27 below above top of ground.
- (4) casing PVC 87
(material) (depth)
10" if telescope see back.
(size)
- (5) screen 40 87
(length) (depth to top)
10 PVC
(size) (material)
- (6) pump 20 1200
(HP) (yield gpm)
Electric
(type power)
- (7) electric log no
(yes or no)

(organization running log)
- (8) how well bottom plugged Cap

CODED

RECEIVED


JUN 30 1987

Department of Natural Resources
Bureau of Land & Water Resources

DRILLERS REMARKS:

If well telescopes please sketch and show depths.

GROUND LEVEL

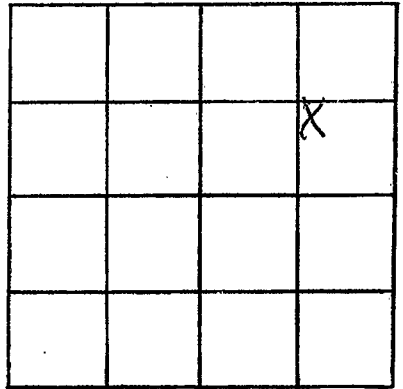

SECTION 35

Please indicate well location X.

ADDITIONAL INFORMATION

If more than one screen,
show locations of each on sketch.