

MISSISSIPPI DEPARTMENT OF NATURAL RESOURCES

Bureau of Land and Water Resources

Southport Mall

P.O. Box 10631

Jackson, Mississippi 39209

WATER WELL DRILLERS LOG

CODED

Tap #  
87203-DCP-01  
LEFLORE  
C 113

7-22  
date well completed

1987 Dyer Well  
firm name

Leflore  
county well located

LANDOWNER Bill Murphree

305 DAINN ST.  
RALEVILLE MS. 38771  
(mailing address)

description of formations encountered

from to

CLAY	0	30
FINE SAND	30	42
SAND + GRAVEL	42	62
FINE SAND	62	70
SAND + GRAVEL	70	102

CODED

WELL LOCATION:

sec 35 T 21 N R 2 S  
10 miles West of Winter City  
(distance) (direction) (nearest town)

WELL PURPOSE: Irrigation  
(home, irrigation, municipal, industrial)

WELL COMPLETION DATA:

- (1) diameter (inches) 10"
- (2) total depth (feet) 102
- (3) static water level (feet) \_\_\_\_\_ below top of ground.
- (4) casing PVC (material), \_\_\_\_\_ (depth), 10" (size) if telescope see back.
- (5) screen 40' (length), \_\_\_\_\_ (depth to top), 10" (size), \_\_\_\_\_ (material)
- (6) pump 15 (HP), 800 (yield gpm), Electric (type power)
- (7) electric log No (yes or no), None (organization running log)
- (8) how well bottom plugged Plate

RECEIVED


JUL 27 1987

Department of Natural Resources  
Bureau of Land & Water Resources

DRILLERS REMARKS:

If well telescopes please  
sketch and show depths.

GROUND LEVEL

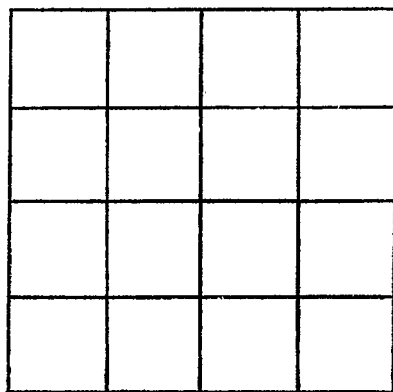

SECTION \_\_\_\_\_

Please indicate well location X.

ADDITIONAL INFORMATION

If more than one screen,  
show locations of each on sketch.