Date drilling completed: 4-13-06	Jackson, MS 39289-0631 (601)961-5210	L. S. Elevation:
	(601)354-6938 (fax)	E-log #:
State Law requires that this report be 30 days of completion of drilling of the	prepared by the driller in detail and filed well.	d with the Department within
Well Owner Information		Vell Location
Owner Name Tackett Fish Far	M Latitude: 33,39 35	.5N 90 25 56.9W
Mailing Address: 23939 County Ros	A NIE CHEME (CHE)	e one): Conventional Survey,
		eld GPS, Survey-grade GPS
	W 1/2 Sw 1/4 Sec 29	Twn_21N_Rng2W
Schlater, MS 36 City State	8952 Zip Code Distance Direction	
Telephone No. (662-254-7322	Miles _ NW	
	Well Data	PD 54 (2-11)
Purpose of Well (circle one) Home Industrial	Public Supply Irrigation Fish Culture	PD 54 Gw Replacement 2955
Date well drilling started: 4-13-06		4-13-06
If flowing, method of flow regulation: Valve		
Static Water Level: 53' feet above of be		4-14-06
Method of Measurement (circle one) Steel tape	electric tape air line other:	<del></del>
Hole depth: 136' Well depth: 1	Well grouted to a depth of	10
Type of grout (circle one): Cement Bento	hile Mix	
Casing length: 76 feet Casing diamet	or:inches Type of casing:	PVC Sch.40
Screen length: 60 feet Screen diamet	ter: 16 inches Type of screen:	PVC Sch.40
Screen slot size: . 050 inches Settin	g depth: From 77 feet to	136 feet
Type of completion (circle all applicable): Gravel	packed Underreamed Telescoped Ope	en hole Natural Development
Other (	describe):	
Top of lap pipe or reduction in casing:	feet. If telescoped or more than one so	reen, describe on back of page
Logs run (circle all applicable): No log run Electri		1
Name of organization running log(s):		
certify that the well was drilled, constructed, and	d completed in accordance with all applicable	e requirements of the Mississippi
Department of Environmental Quality and/or the	Mississippi Department of Health regulation	ns and state laws.
Irrigation Equipment I Patrick M. Chism 0695	117 11 414	
Print Name of Water Well Contractor and License N	o. Signature o	f Water Well Contractor

**State Well Report** 

Part 1
Mississippi Department of Environmental Quality
Office of Land and Water Resources

P.O. Box 10631 Jackson, MS 39289-0631 For Office Use Only:

Aquifer:

Well #:



Leflore

Permit#: 604(00)
Irrigation Equipment
Driller:

ounty:

f	State w	en keport	For Office Use Only:		
County: Leflore	P	art 1	For Office ose Only.		
Permit #: 6 W 41002		t of Environmental Quality	Aquifer:		
Irrigation Equipment		and Water Resources	Well #: 6-140		
Driller:		30x 10631 AS 39289-0631	L. S. Elevation:		
Date drilling completed: $4-13-06$	· ·	961-5210			
	(601)35	4-6938 (fax)	E-log #:		
State Law requires that this rep 30 days of completion of drilling		driller in detail and filed w	ith the Department within		
	Well Owner Information Well Location				
Owner Name Tackett Fish	Farm	Latitude: 33,39 35.5	5N 90 25 56.9W Longitude: <b>57</b>		
Mailing Address: 23939 County	y Road 523	Method of Lat/Long (circle or			
Schlater, M. City Sta  Telephone No. (662-254-732)	-	USGS quad, Hand-held  W 4 Sec 29  Distance Direction  Miles NW	GPS, Survey-grade GPS  Twn_21N_Rng2W  Nearest Town of Schlater		
	Well	Dota .			
	Well		PD 54		
Purpose of Well (circle one) Home Ind	ustrial Public Supply	Irrigation Fish Culture	Replacement		
Date well drilling started: 4-13-06  Date well drilling completed: 4-13-06					
If flowing, method of flow regulation: ValveOther (describe)					
Static Water Level: 53' feet ab			1		
Method of Measurement (circle one)	eel tape electric tape	air line other			
Method of Measurement (circle one) (steel tabe electric tape air line other:  Hole depth: 136' Well depth: 136' Well grouted to a depth of feet					
Type of grout (circle one): Cement	Bentonite Mix				
76	ng diameter:	PV_inches Type of casing:	VC Sch.40		
Screen length: 60 feet Screen	en diameter: 16	inches Type of screen:	PVC Sch.40		
Screen slot size: . 050 inches	Setting depth: From	77 feet to	136 feet		
Type of completion (circle all applicable):	Gravel packed Under	reamed Telescoped Open	hole Natural Development		
	Other (describe):	· · · · · · · · · · · · · · · · · · ·			
Top of lap pipe or reduction in casing:feet. If telescoped or more than one screen, describe on back of page					
Logs run (circle all applicable): No log run Electric Gamma Ray Density Sonic Neutron Other:					
Name of organization running log(s):  I certify that the well was drilled, constructed, and completed in accordance with all applicable requirements of the Mississippi					
		/\	requirements of the Mississippi		
Department of Environmental Quality of	- 4/ 4 1 C		3 444 3		

Irrigation Equipment Inc. Patrick M. Chism 0695

Print Name of Water Well Contractor and License No.

RECEIVED

Signature of Water Well Contractor

APR 2 5 2006


BY: OLWR

Ground Level

Desc	ription of Formations Encountered	From	To
Clay		0	31
Fine	Sand/gravel Sand/gravel	32	48
Med.	Sand/gravel	49	136
			<u> </u>
			$\vdash$
			$\sqcup$
			<b>├</b>
L			
			<del></del>
			$\vdash$
			<b>  </b>
			$\vdash$
			1
			$\vdash$
L			<u></u> _

If more than one screen, show location of each on sketch

Sketch the property layout and include the following: 1) the well location; 2) any permanent structures on the property that may aid in locating the well; 3) any roads, power lines, or other items that may aid in locating the property and the well; 4) indicate direction.

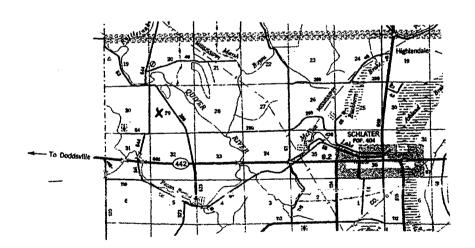

andanmer Name:		

Signature of Water Well Contractor

## STATE WELL REPORT

## Part 2

County: Leflore

Permit#: 6W 41002 [rrigation Equipment Driller: Pump Installer's Completion Report
Mississippi Department of Environmental Quality
Office of Land and Water Resources
P.O. Box 10631
Jackson, MS 39289-0631
(601)961-5210

For Office Use Only:		
Aquifer:		
Well#: C-140		
Elevation:		

Date completed: 4-13-06	Jackson, MS 39289-063		Well #:	-140
Copy information from block on Part 1	(601)961-5210 (601)354-6938 (fax)		Elevation:	
This part of the report must be completed by report must be attached and both parts filed	l with the Department o			
Well Owner Information	On		Well Location	
Owner Name: Tackett Fish F		Latitude:	Longitude:	
Mailing Address: 23939 County Road 523		Method of Lat/Long (check one): Conventional Survey,		
		USGS quad, Hand-held GPS, Survey-grade GPS		
Schlater MS City State	38952	¼¼ Sec_ 29 _ T_21N_R_2W_		
662-254-7322	Zip Code	Distance Di	rection Nearest To	vn
†	Telephone No. () 5Miles NWof Schlater			r
Pump Type		L	Power Type	
Circle one			Circle one	
Air Lift Jet	Submersible	Diesel Engine	Gasoline Engine	Natural Gas
Bucket Piston	Turbine	Hectric Motor	Hand	Tractor PTO
Centrifugal Rotary	Flowing Well	Windmill	Other (specify):	
Other (specify): Horse Power Rating of Motor:				
Date Pump Installed: 4-14-06	6	Setting Depth:	80	feet
Rated Pump Capacity: 2500 G	allons Per Minute	Number of Stages: _	2	-
Pump Test Data		Metho	od of Measuring Water I	.evel
Date Well Tested:			Circle one	
Static Water Level (A):Feet Be			ctric Measuring Line	
Pumping Water Level (B):Feet Be	elow Land Surface	Other (specify):		
Drawdown [(B) - (A)]:Feet Be	elow Land Surface	For flowing well, me	asured shut in head:	feet
Test Pumping Rate:G	allons Per Minute	Well yielded	GPM with a d	rawdown of
Duration of Pump Test (minimum 4 hours):	hours	fec	et after ho	urs of pumping
I HEREBY CERTIFY that the above statement Patrick M. Chism 06 Print Name of Pump Installer and License No.	595	Patro M	Pump Installer	i: OLWR-SWR-1B

RECEIVED

APR 2 5 2006

BY: OLWR