Leflore
GW 4/378 gation Equipment
f
∠ drilling completed: 10-13-06

## State Well Report

Part 1

Mississippi Department of Environmental Quality
Office of Land and Water Resources
P.O. Box 10631
Jackson, MS 39289-0631
(601)961-5210
(601)354-6938 (fax)

For Office Use Only:	
Aquifer:	
Well #: <u>C-247</u>	
L. S. Elevation:	
E-log #:	_

State Law requires that this report be prepared by the driller in detail and filed with the Department within 30 days of completion of drilling of the well.

30 days of completion of drilling of the well.	
Well Owner Information	Well Location 33 38 25.2 90 21 15.0
Owner Name Live Oaks Planting Co.	Latitude:°" Longitude:°"
Mailing Address: 23939 County Road 523	Method of Lat Dong (circle one): Conventional Survey,
(A)	USGS quad, Hand-held GPS, Survey-grade GPS
	NSW 1/4 SE 1/4 Sec 36 Twn 21N Rng 2W
Schlater MS 38952	
City State Zip Code 662-254-7322	Distance Direction Search Town Wiles of Sch Later, D
Telephone No. ()	
Well I	Pata 14 2006
Purpose of Well (circle one) Home Industrial Public Supply	Ifrigation Fish Culture Other:
Date well drilling started: 10-13-06 Date w	vell drilling completed: 10-13-0 MD JOINT WATER MANAGEMENT DISTRICT
If flowing, method of flow regulation: Valve Other (d	escribe)
Static Water Level: 42' feet above or below (circle one) l	and surface Date measured: 10-25-06
Method of Measurement (circle one) scel tape electric tape	air line other:
Hole depth: 120 Well depth: 120	Well grouted to a depth of 10 feet
Type of grout (circle one): Cement Bentonite Mix	
Casing length: 80 feet Casing diameter: 16	_inches Type of casing: PVC Sch. 40
Screen length: 40 feet Screen diameter: 16	inches Type of screen: PVC Sch. 40
Screen slot size: . 050 inches Setting depth: From	81feet_to120feet
Type of completion (circle all applicable): Gravel packed Under	reamed Telescoped Open hole Natural Development
Other (describe):	
Top of lap pipe or reduction in casing:feet. If tel	lescoped or more than one screen, describe on back of page
Logs run (circle all applicable): No log run Electric Gamma Ray	Density Sonic Neutron Other:
Name of organization running log(s):	
I certify that the well was drilled, constructed, and completed in	i l
Department of Environmental Quality and/or the Mississippi Dep	partment of Health regulations and state laws.
Irrigation Equipment Inc. Patrick M. Chism 0695	Ratural M Chan.
Print Name of Water Well Contractor and License No.	Signature of Water Well Contractor

41378

ient
ient
06

## **State Well Report**

Part 1

Mississippi Department of Environmental Quality
Office of Land and Water Resources P.O. Box 10631 Jackson, MS 39289-0631 (601)961-5210 (601)354-6938 (fax)

F	or Office Use Only:
Aquifer:	
Well #:	C-141)
L. S. Ele	vation:
E-log #:	


30 days of completion of drilling of the well.	urmer in detail and med with the Department within
Well Owner Information	Well Location
Owner Name Live Oaks Planting Co.	33 38 25.2 90 21 15.0
	Latitude: "Longitude: " " Longitude: " " " " " " " " " " " " " " " " " " "
Mailing Address: 23939 County Road 523	Method of Lat/Long (circle one): Conventional Survey,
•	USGS quad, Hand-held GPS, Survey-grade GPS
Schlater MS 38952	W 1/4 SE 1/4 Sec 36 Twn 21N Rng 2W
City State Zip Code 662-254-7322 Telephone No. ( )	Distance Direction Nearest Town Miles of Schlater
Well D	Pata
Purpose of Well (circle one) Home Industrial Public Supply	Neigation Fish Culture Other:
Date well drilling started: 10-13-06 Date w	rell drilling completed: 10-13-06
If flowing, method of flow regulation: Valve Other (de	escribe)
Static Water Level: 42' feet above or below (circle one) la	and surface Date measured: 10-25-06
Method of Measurement (circle one) seel tape electric tape	air line other:
Hole depth: 120 Well depth: 120	Well grouted to a depth offeet
Type of grout (circle one): Cement Bentonite Mix	
Casing length: 80 feet Casing diameter: 16	_inches Type of casing: PVC Sch. 40
Screen length: 40 feet Screen diameter: 16	inches Type of screen: PVC Sch. 40
Screen slot size: o 50inches	81 feet to 120 feet
Type of completion (circle all applicable): Travel packed Under	reamed Telescoped Open hole Natural Development
Other (describe):	
Top of lap pipe or reduction in casing:feet. If tele	escoped or more than one screen, describe on back of page
Logs run (circle all applicable): No log run Electric Gamma Ray	Density Sonic Neutron Other:
Name of organization running log(s):	_
I certify that the well was drilled, constructed, and completed in a	eccordance with all applicable requirements of the Mississippi
Department of Environmental Quality and/or the Mississippi Dep	· · · · · · · · · · · · · · · · · · ·
Irrigation Equipment Inc.	0,1
Patrick M. Chism 0695	Katul M Chu
Print Name of Water Well Contractor and License No.	Signature of Water Well Contractor

Ground Level

		To
Description of Formations Encountered Clay	0	21
Fine Sand	22	35
Fine Sand/gravel Med. Sand/gravel	36	50
Med. Sand/gravel	51	117
Clay	118	120
		1
	ļ	<b></b>
	<del> </del>	<b>├</b>
	ļ	11
	<b></b>	$\vdash$
	<u> </u>	
	<del> </del>	$\vdash$
	<u> </u>	
	<del>                                     </del>	
	ļ	1
	<b>├</b> ─-	<b> </b>
	<u> </u>	
	ļ	1
	↓	ļ
	<del> </del>	1
	<del></del>	<u> </u>
	<u> </u>	<u> </u>

If more than one screen, show location of each on sketch

Sketch the property layout and include the following: 1) the well location; 2) any permanent structures on the property that may aid in locating the well; 3) any roads, power lines, or other items that may aid in locating the property and the well; 4) indicate direction.

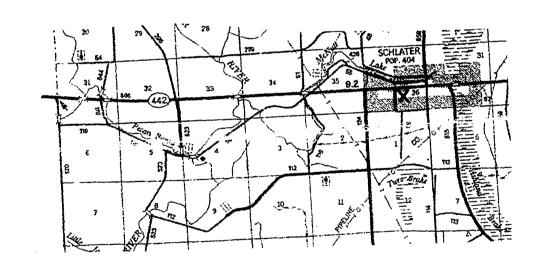

Landowner Name:	

Signature of Water Well Contractor

## STATE WELL REPORT

## Part 2

County: Leflore Pump Installer's Completion Report
Mississippi Department of Environmental Quality
Office of Land and Water Resources Pennit#: 6W41378

Irrigation Equipment

Driller: P.O. Box 10631 Jackson, MS 39289-0631 (601)961-5210 (601)354-6938 (fax) Date completed: 10-13-06

For Office Use Only:		
Aquifer:	•	
Well#:	- 141)	
Elevation:		

Copy information	from block on Part I		34-0936 (IAK)		
This part of the report must be completed by a licensed water well contractor or a licensed pump installer. A copy of Part 1 of the report must be attached and both parts filed with the Department at the above address within 30 days of well completion.					
	Well Owner Info	mation	T	Well Location	
Owner Name:	Live Oaks P	lanting Co.	Latitude:	Longitude:_	
Mailing Address: 23939 County Road 523		Method of Lat/I	ong (check one): Conventi	ional Survey,	
		- M	USGS quad	, Hand-held GPS, Su	rvey-grade GPS
	Schlater Str		SW 1/2 SE	_¼ Sec_ 36 T_21N	_R2W
	662-254-7	-	i	Direction Nearest	
Telephone No. (_			Miles	of Schl	ater
	Ришр Тур			Power Type	
Circle one			Circle one		
Air Lift	<b>J</b> et	Submersible	Diesel Engine	Gasoline Engine	Natural Gas
Bucket	Piston	Turbine	Electric Motor	Hand	Tractor PTO
Centrifugal	Rotary	Flowing Well	Windmill	Other (specify):	
Other (specify):				ting of Motor. 60	
Date Pump Installed: 10-25-06		Setting Depth:	70	feet	
Rated Pump Capacity: 2500-3000 Gallons Per Minute			Number of Stag	<b>cs</b> :1	
	Pump Test D	ata	1	Method of Measuring War	ter Levd
Date Well Tested:	·			Circle one	
Static Water Leve	l (A):l	Feet Below Land Surface	Air Line	Electric Measuring Line	Steel Tape
Pumping Water Level (B):Feet Below Land Surface		Other (specify):	<u> </u>		
Drawdown [(B) - (A)]:Feet Below Land Surface		For flowing wel	l, measured shut in head:	feet	
Test Pumping Rate:Gallons Per Minute		Well yielded_	GPM with	a drawdown of	
Duration of Pump Test (minimum 4 hours): hours feet after hours of pumpin			hours of pumping		

I HEREBY CERTIFY that the above statements are true to the bes	t of my kng@ledge.
Patrick M. Chism 0695	Patrick M Chini
Print Name of Pump Installer and License No. (if applicable)	Signature of Pump Installer
	Form: OLWR-SWR-1B