

before
 411447
 Irrigation Equipment
 drilling completed: 11-29-06

State Well Report Part I

Mississippi Department of Environmental Quality
 Office of Land and Water Resources
 P.O. Box 10631
 Jackson, MS 39289-0631
 (601)961-5210
 (601)354-6938 (fax)

For Office Use Only:
 Aquifer: _____
 Well #: C-148
 L. S. Elevation: _____
 E-log #: _____

State Law requires that this report be prepared by the driller in detail and filed with the Department within 30 days of completion of drilling of the well.


Well Owner Information Owner Name: <u>Marlin Jennings</u> Mailing Address: <u>Box 192</u> <u>Schlater MS 38952</u> City State Zip Code Telephone No. () _____		Well Location 33 38' 19.1N 90° 21' 59.5 Latitude: _____ Longitude: _____ Method of Lat/Long (circle one): Conventional Survey, USGS quad, Hand-held GPS, Survey-grade GPS <u>SE 1/4 SE 1/4 Sec 35 Twn 21N Rng 2W</u> Distance Direction Nearest Town Miles <u>West</u> of <u>Schlater</u>
--	--	---

Well Data

Purpose of Well (circle one) Home Industrial Public Supply Irrigation Fish Culture Other: _____
 Date well drilling started: 11-29-06 Date well drilling completed: 11-29-06
 If flowing, method of flow regulation: Valve _____ Other (describe) _____
 Static Water Level: 47' feet above or below (circle one) land surface Date measured: 12-8-06
 Method of Measurement (circle one) steel tape electric tape air line other: _____
 Hole depth: 117 Well depth: 117 Well grouted to a depth of 10 feet
 Type of grout (circle one): Cement Bentonite Mix
 Casing length: 77 feet Casing diameter: 10 inches Type of casing: PVC 160
 Screen length: 40 feet Screen diameter: 10 inches Type of screen: PVC 160
 Screen slot size: .050 inches Setting depth: From 78 feet to 117 feet
 Type of completion (circle all applicable): Gravel packed Underreamed Telescoped Open hole Natural Development
 Other (describe): _____
 Top of lap pipe or reduction in casing: _____ feet. If telescoped or more than one screen, describe on back of page
 Logs run (circle all applicable): No log run Electric Gamma Ray Density Sonic Neutron Other: _____
 Name of organization running log(s): _____

I certify that the well was drilled, constructed, and completed in accordance with all applicable requirements of the Mississippi Department of Environmental Quality and/or the Mississippi Department of Health regulations and state laws.

Irrigation Equipment Inc.
Patrick M. Chism 0695
 Print Name of Water Well Contractor and License No.

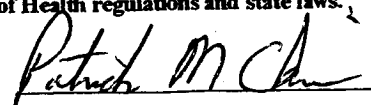
 Signature of Water Well Contractor

RECEIVED

YMD JOINT WATER
MANAGEMENT DISTRICT

411447

State Well Report

Part 1

Mississippi Department of Environmental Quality
Office of Land and Water Resources
P.O. Box 10631
Jackson, MS 39289-0631
(601)961-5210
(601)354-6938 (fax)

County: Leflore
Permit #: 6041447
Irrigation Equipment
Driller: _____
Date drilling completed: 11-29-06

For Office Use Only:
Aquifer: _____
Well #: C-148
L. S. Elevation: _____
E-log #: _____

State Law requires that this report be prepared by the driller in detail and filed with the Department within 30 days of completion of drilling of the well.

Well Owner Information		Well Location	
Owner Name	<u>Marlin Jennings</u>	33 38' 19.1N	90° 21' 59.5W
Mailing Address:	<u>Box 192</u>	Latitude: _____	Longitude: _____
		Method of Lat/Long (circle one): <u>19</u> Conventional Survey, <u>59</u>	
		USGS quad, Hand-held GPS, Survey-grade GPS	
	<u>Schlater MS 38952</u>	SE ¼ SE ¼ Sec <u>35</u>	Twn <u>21N</u> Rng <u>2W</u>
	City State Zip Code	Distance _____ Miles	Direction <u>West</u> of Nearest Town <u>Schlater</u>
Telephone No. ()	_____		

Well Data

Purpose of Well (circle one) Home Industrial Public Supply Irrigation Fish Culture Other: _____

Date well drilling started: 11-29-06 Date well drilling completed: 11-29-06

If flowing, method of flow regulation: Valve _____ Other (describe) _____

Static Water Level: 47' feet above of below (circle one) land surface Date measured: 12-8-06

Method of Measurement (circle one) steel tape electric tape air line other: _____

Hole depth: 117 Well depth: 117 Well grouted to a depth of 10 feet

Type of grout (circle one): Cement Bentonite Mix

Casing length: 77 feet Casing diameter: 10 inches Type of casing: PVC 160

Screen length: 40 feet Screen diameter: 10 inches Type of screen: PVC 160

Screen slot size: .050 inches Setting depth: From 78 feet to 117 feet

Type of completion (circle all applicable): Gravel packed Underreamed Telescoped Open hole Natural Development

Other (describe): _____

Top of lap pipe or reduction in casing: _____ feet. If telescoped or more than one screen, describe on back of page

Logs run (circle all applicable): No log run Electric Gamma Ray Density Sonic Neutron Other: _____

Name of organization running log(s): _____

I certify that the well was drilled, constructed, and completed in accordance with all applicable requirements of the Mississippi

Department of Environmental Quality and/or the Mississippi Department of Health regulations and state laws.

Irrigation Equipment Inc.
Patrick M. Chism 0695

Patrick M Chism
Signature of Water Well Contractor

Print Name of Water Well Contractor and License No.

RECEIVED

DEC 18 2006

BY: OLWR

If well telescopes please sketch below and show depths.


Ground Level _____

C-

Description of Formations Encountered	From	To
Clay	0	29
Fine Sand	30	37
Fine Sand/gravel	38	55
Med. Sand/gravel	56	117

If more than one screen, show location of each on sketch

Sketch the property layout and include the following: 1) the well location; 2) any permanent structures on the property that may aid in locating the well; 3) any roads, power lines, or other items that may aid in locating the property and the well; 4) indicate direction.

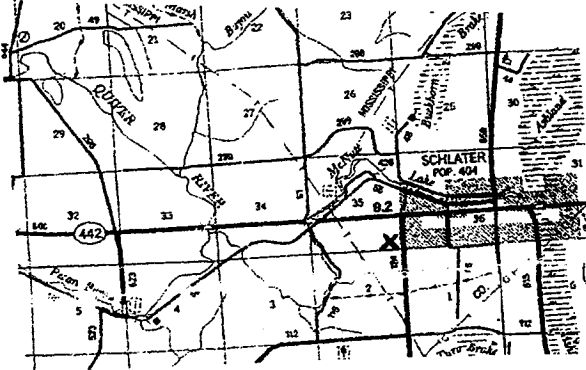

Landowner Name: _____



 Signature of Water Well Contractor

STATE WELL REPORT

Part 2

Pump Installer's Completion Report
 Mississippi Department of Environmental Quality
 Office of Land and Water Resources
 P.O. Box 10631
 Jackson, MS 39289-0631
 (601)961-5210
 (601)354-6938 (fax)

County: Leflore
 Permit #: OW 41447
 Irrigation Equipment
 Driller: _____
 Date completed: 11-29-06

For Office Use Only:

Aquifer: _____
 Well #: C-148
 Elevation: _____

This report should be prepared by the pump installer in detail and filed with the Department within 30 days of the installation of pump.

Well Owner Information	Well Location
Owner Name: <u>Marlin Jennings</u>	Latitude: _____ Longitude: _____
Mailing Address: <u>Box 192</u>	Method of Lat/Long (circle one): Conventional Survey,
<u>Schlater MS 38952</u>	USGS quad, Hand-held GPS, Survey-grade GPS
City State Zip Code	SE $\frac{1}{4}$ SE $\frac{1}{4}$ Sec 35 Twn 21N Rng 2W
Telephone No. () _____	Distance Direction Nearest Town
	_____ Miles West of Schlater

Pump Type Circle one	Power Type Circle one
Air Lift Jet <input checked="" type="radio"/> Submersible	Diesel Engine Gasoline Engine Natural Gas
Bucket Piston Turbine	<input checked="" type="radio"/> Electric Motor Hand Tractor PTO
Centrifugal Rotary Flowing Well	Windmill Other (specify): _____
Other (specify): _____	Horse Power Rating of Motor: <u>30</u>
Date Pump Installed: <u>12-8-06</u>	Setting Depth: <u>70</u> feet
Rated Pump Capacity: <u>1150</u> Gallons Per Minute	Number of Stages: <u>1</u>

Pump Test Data	Method of Measuring Water Level Circle one
Date Well Tested: _____	Air Line Electric Measuring Line Steel Tape
Static Water Level (A): _____ Feet Below Land Surface	Other (specify): _____
Pumping Water Level (B): _____ Feet Below Land Surface	For flowing well, measured shut in head: _____ feet
Drawdown [(B) - (A)]: _____ Feet Below Land Surface	Well yielded _____ GPM with a drawdown of
Test Pumping Rate: _____ Gallons Per Minute	_____ feet after _____ hours of pumping
Duration of Pump Test (minimum 4 hours): _____ hours	

I HEREBY CERTIFY that the above statements are true to the best of my knowledge.

Patrick M. Chism 0695
 Print Name of Pump Installer and License No. (if applicable)

Patrick M. Chism
 Signature of Pump Installer

RECEIVED

DEC 18 2006
 BY: OLWR