

**State Well Report
Part I**

Mississippi Department of Environmental Quality
Office of Land and Water Resources
P.O. Box 10631
Jackson, MS 39289-0631
(601)961-5210
(601)354-6938 (fax)

For Office Use Only

Aquifer: _____
Well #: _____
L.S. Elevation: _____
E-log #: _____

County: Leflore
Permit #: _____
Irrigation Equipment
Driller: _____
Date drilling completed: 11-3-07

State Law requires that this report be prepared by the driller in detail and filed with the Department within 30 days of completion of drilling of the well.

Well Owner Information	Well Location
Owner Name: <u>Buckhorn Planting Co.</u>	Latitude: <u>33.38.59.9</u> Longitude: <u>90.23.00.7</u>
Mailing Address: <u>c/o Aven Whittington</u>	Method of Well Log (circle one): <u>Conventional Survey</u>
<u>P.O. Box 211</u>	USGS quad, Hand-held GPS, Survey-grade GPS
<u>Schlater Ms. 38952</u>	<u>NE 1/4 NE 1/4 Sec 34 Twn 21N Rng 2W</u>
City State Zip Code	Distance Direction Nearest Town
Telephone No. <u>(662) 658-1250</u>	<u>1 Miles W of Schlater</u>

Well Data

Purpose of Well (circle one) Home Industrial Public Supply Irrigation Fish Culture Other Replacement GW-04110

Date well drilling started: 11-3-07 Date well drilling completed: 11-3-07

If flowing, method of flow regulation: Valve _____ Other (describe) _____

Static Water Level: 48 feet above (or below) (circle one) land surface Date measured: 11-5-07

Method of Measurement (circle one) steel tape electric tape air line other _____

Hole depth: 122 Well depth: 122 Well grouted to a depth of 10 feet

Type of grout (circle one): Coarse Beatonite Mix

Casing length: 82 feet Casing diameter: 16 inches Type of casing: PVC

Screen length: 40 feet Screen diameter: 16 inches Type of screen: PVC

Screen slot size: .050 inches Setting depth: From 83 feet to 122 feet

Type of completion (circle all applicable): Gravel packed Underreamed Telescoped Open hole Natural Development
Other (describe): _____

Top of lap pipe or reduction in casing: _____ feet. If telescoped or more than one screen, describe on back of page

Logs run (circle all applicable) No log run Electric Gamma Ray Density Sonic Neutron Other _____

Name of organization running log(s): _____

RECEIVED

NOV 15 2007
JOINT WATER
MANAGEMENT DISTRICT

I certify that the well was drilled, constructed, and completed in accordance with all applicable requirements of the Mississippi Department of Environmental Quality and/or the Mississippi Department of Health regulations and state laws.

Irrigation Equipment Inc.
Patrick M. Chism 0695

Patrick M. Chism

**State Well Report
Part I**

Mississippi Department of Environmental Quality
Office of Land and Water Resources
P.O. Box 10631
Jackson, MS 39289-0631
(601)961-5210
(601)354-6938 (fax)

County: Leflore
 Permit #: 00012240
 Irrigation Equipment
 Driller: _____
 Date drilling completed: 11-3-07

For Office Use Only:
 Aquifer: _____
 Well #: C-154
 L. S. Elevation: _____
 E-log #: _____

State Law requires that this report be prepared by the driller in detail and filed with the Department within 30 days of completion of drilling of the well.

Well Owner Information	Well Location
Owner Name: <u>Buckhorn Planting Co.</u>	Latitude: <u>33.38.59.9</u> Longitude: <u>90.23.00.7</u>
Mailing Address: <u>C/O Aven Whittington</u>	<u>39 00</u> <u>01</u>
<u>P.O. Box 211</u>	Method of Lat/Long (circle one): <u>Conventional Survey</u>
<u>Schlater Ms. 38952</u>	USGS quad, Hand-held GPS, Survey-grade GPS
City State Zip Code	<u>NE 1/4 NE 1/4 Sec 34 Twn 21N Rng 2W</u>
Telephone No. <u>(662) 658-1250</u>	Distance Direction Nearest Town
	<u>1</u> Miles <u>W</u> of <u>Schlater</u>

Well Data

Purpose of Well (circle one) Home Industrial Public Supply Irrigation Fish Culture Other Replacement

Date well drilling started: 11-3-07 Date well drilling completed: 11-3-07

If flowing, method of flow regulation: Valve _____ Other (describe) _____

Static Water Level: 48 feet above (or below) (circle one) land surface Date measured: 11-5-07

Method of Measurement (circle one) steel tape electric tape air line other _____

Hole depth: 122 Well depth: 122 Well grouted to a depth of 10 feet

Type of grout (circle one): Cement Bentonite Mix

Casing length: 82 feet Casing diameter: 16 inches Type of casing: PVC

Screen length: 40 feet Screen diameter: 16 inches Type of screen: PVC

Screen slot size: .050 inches Setting depth: From 83 feet to 122 feet

Type of completion (circle all applicable): Gravel packed Underreamed Telescoped Open hole Natural Development

Other (describe): _____

Top of lap pipe or reduction in casing: _____ feet. If telescoped or more than one screen, describe on back of page

Logs run (circle all applicable): No log run Electric Gamma Ray Density Sonic Neutron Other: _____

Name of organization running log(s): _____

I certify that the well was drilled, constructed, and completed in accordance with all applicable requirements of the Mississippi Department of Environmental Quality and/or the Mississippi Department of Health regulations and state laws.

Irrigation Equipment Inc.
 Patrick M. Chism 0695

Patrick M. Chism
 Signature of Water Well Contractor

Print Name of Water Well Contractor and License No.

STATE WELL REPORT

Part 2

Pump Installer's Completion Report
Mississippi Department of Environmental Quality
Office of Land and Water Resources
P.O. Box 10631
Jackson, MS 39289-0631
(601)961-5210
(601)354-6938 (fax)

For Office Use Only:

Agency: _____

Well #: C-154

Elevation: _____

County: Leflore
Permit #: 06642240
Irrigation Equipment
Driller: _____
Date completed: 11-3-07

This report should be prepared by the pump installer in detail and filed with the Department within 30 days of the installation of pump.

Well Owner Information	Well Location
Owner Name: <u>Buckhorn Planting Co.</u>	Latitude: _____ Longitude: _____
Mailing Address: <u>C/o Aven Whittington</u>	Method of Lat/Long (circle one): <input type="radio"/> Conventional Survey,
<u>P.O. Box 211</u>	<input type="radio"/> USGS quad, <input type="radio"/> Hand-held GPS, <input type="radio"/> Survey-grade GPS
<u>Schlater Ms. 38952</u>	<u>NE 1/4 NE 1/4 Sec. 34 Twp 21N Rng 2W</u>
City State Zip Code	Distance Direction Nearest Town
Telephone No. <u>(662) 658-1250</u>	<u>1 Miles W of Schlater</u>

Pump Type Circle one	Power Type Circle one
Air Lift <input type="checkbox"/> Jet <input type="checkbox"/> Submersible <input type="checkbox"/>	Diesel Engine <input type="checkbox"/> Gasoline Engine <input type="checkbox"/> Natural Gas <input type="checkbox"/>
Bucket <input type="checkbox"/> Piston <input type="checkbox"/> Turbine <input checked="" type="checkbox"/>	Electric Motor <input checked="" type="checkbox"/> Hand <input type="checkbox"/> Tractor PTO <input type="checkbox"/>
Centrifugal <input type="checkbox"/> Rotary <input type="checkbox"/> Flowing Well <input type="checkbox"/>	Windmill <input type="checkbox"/> Other (specify): _____
Other (specify): _____	Horse Power Rating of Motor: <u>60</u>
Date Pump Installed: <u>11-5-07</u>	Setting Depth: <u>70</u> feet
Rated Pump Capacity: <u>2800 ±</u> Gallons Per Minute	Number of Stages: <u>1</u>

Pump Test Data	Method of Measuring Water Level Circle one
Date Well Tested: _____	Air Line <input type="checkbox"/> Electric Measuring Line <input type="checkbox"/> Steel Tape <input type="checkbox"/>
Static Water Level (A): _____ Feet Below Land Surface	Other (specify): _____
Pumping Water Level (B): _____ Feet Below Land Surface	For flowing well, measured shut in head: _____ feet
Drawdown [(B)-(A)]: _____ Feet Below Land Surface	Well yielded _____ GPM with a drawdown of _____ feet after _____ hours of pumping
Test Pumping Rate: _____ Gallons Per Minute	
Duration of Pump Test (minimum 4 hours): _____ hours	

I HEREBY CERTIFY that the above statements are true to the best of my knowledge.

Patrick M. Chism 0695

Print Name of Pump Installer and License No. (if applicable)

[Signature]
Signature of Pump Installer

6042240

Buckhorn Planting Co.

C-154


R 2 W

R 1 W

TALLAHATCHIE COUNTY

LEFLORE ROAD INDEX

- 1 A1
- 2 A1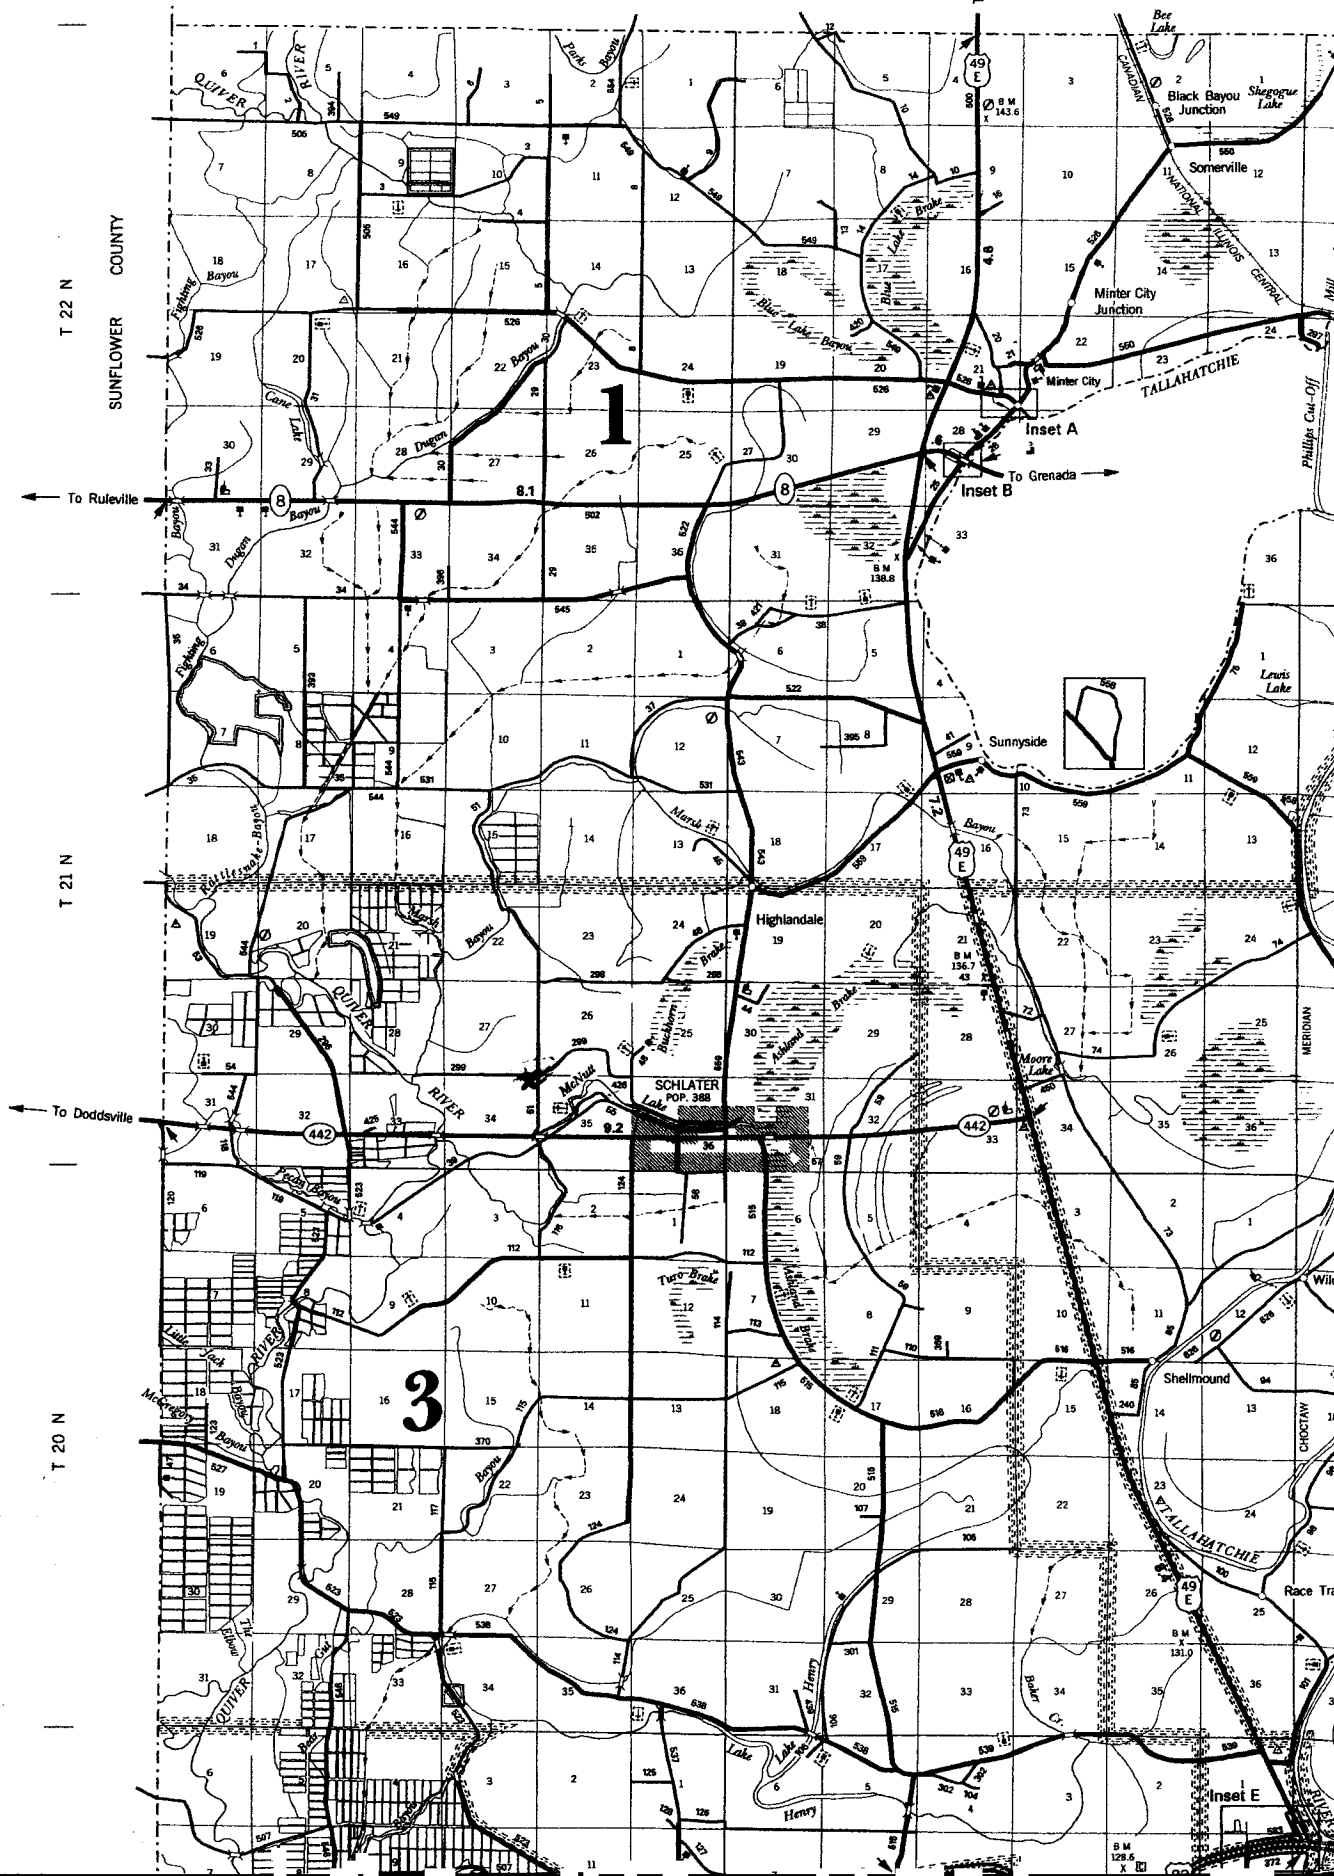
SUNFLOWER COUNTY

To Ruleville

T 21 N

To Doddsville

T 20 N

To Sumner

To Grenada

Meridian

Choctaw

Race Tra

1

3

Inset A

Inset B

Inset E

Black Bayou Junction
Somerville
Minter City Junction
Minter City

Schlater Lake
POP. 368

Shellmound

Inset E