

Permit #: 42681
 Irrigation Equipment
 Driller:
 Date drilling completed: 7-3-08

State Well Report

Part I

Mississippi Department of Environmental Quality
 Office of Land and Water Resources
 P.O. Box 10631
 Jackson, MS 39289-0631
 (601)961-5210
 (601)354-6938 (fax)

For Office Use Only:
 Aquifer:
 Well #: C157
 L. S. Elevation:
 E-log #:

State Law requires that this report be prepared by the driller in detail and filed with the Department within 30 days of completion of drilling of the well.

Well Owner Information	Well Location
Owner Name: <u>Buckhorn Plantation</u> Mailing Address: <u>40 Aven Whittington</u> <u>P.O. Box 211</u> <u>Schlater Ms. 38952</u> City State Zip Code Telephone No. ()	Latitude: <u>33.39.15.9</u> Longitude: <u>90.23.33.8</u> Method of Lat/Long (circle one): Conventional Survey, USGS quad, Hand-held GPS, Survey-grade GPS <u>NW 1/4 SE 1/4 Sec 27 Twn 21N Rng 2W</u> Distance Direction Nearest Town <u>2 Miles NW of Schlater</u>

Well Data

Purpose of Well (circle one) Home Industrial Public Supply Irrigation Fish Culture Other:

Date well drilling started: 7-3-08 Date well drilling completed: 7-3-08

If flowing, method of flow regulation: Valve Other (describe):

Static Water Level: 47 feet above or below (circle one) land surface Date measured: 7-4-08

Method of Measurement (circle one) steel tape electric tape air line other:

Hole depth: 121 Well depth: 121 Well grouted to a depth of 10 feet

Type of grout (circle one): Cement Benonite Mix

Casing length: 81 feet Casing diameter: 16 inches Type of casing: PVC

Screen length: 40 feet Screen diameter: 16 inches Type of screen: PVC

Screen slot size: .050 inches Setting depth: From 82 feet to 121 feet

Type of completion (circle all applicable): Gravel packed Underreamed Telescoped Open hole Natural Development
 Other (describe):

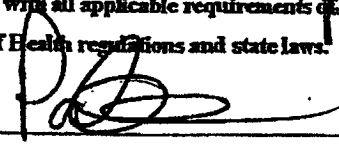
Top of lap pipe or reduction in casing: feet. If telescoped or more than one screen, describe on back of page

Logs run (circle all applicable) No log run Electric Gamma Ray Density Sonic Neutron Other:

Name of organization running log(s):

I certify that the well was drilled, constructed, and completed in accordance with all applicable requirements of the Mississippi Department of Environmental Quality and/or the Mississippi Department of Health regulations and state laws.

Irrigation Equipment Inc
 Patrick M. Chism 0695


 Signature of Water Well Contractor

Print Name of Water Well Contractor and License No.

RECEIVED
 JUL 21 2008
 YMD JOINT WATER
 MANAGEMENT DISTRICT

42681

State Well Report

Part 1

Mississippi Department of Environmental Quality
Office of Land and Water Resources
P.O. Box 10631
Jackson, MS 39289-0631
(601)961-5210
(601)354-6938 (fax)

For Office Use Only:

Aquifer: _____
Well #: C-157
L. S. Elevation: _____
E-log #: _____

County: Leflore
Permit #: 01042681
Irrigation Equipment
Driller: _____
Date drilling completed: 7-3-08

State Law requires that this report be prepared by the driller in detail and filed with the Department within 30 days of completion of drilling of the well.

Well Owner Information	Well Location
Owner Name: <u>Buckhorn Plantation</u>	Latitude: <u>33.39.15.9</u> Longitude: <u>90.23.32.8</u>
Mailing Address: <u>40 Aven Whittington</u>	Method of Lat/Long (circle one): <u>Conventional Survey</u>
<u>P.O. Box 211</u>	USGS quad, Hand-held GPS, Survey-grade GPS
<u>Schlater Ms. 38952</u>	<u>NW 1/4 SE 1/4 Sec 27 Twn 21N Rng 2W</u>
City State Zip Code	Distance Direction Nearest Town
Telephone No. ()	<u>2</u> Miles <u>NW</u> of <u>Schlater</u>

Well Data

Purpose of Well (circle one) Home Industrial Public Supply Irrigation Fish Culture Other: _____

Date well drilling started: 7-3-08 Date well drilling completed: 7-3-08

If flowing, method of flow regulation: Valve _____ Other (describe) _____

Static Water Level: 47 feet above of below (circle one) land surface Date measured: 7-4-08

Method of Measurement (circle one) steel tape electric tape air line other: _____

Hole depth: 121 Well depth: 121 Well grouted to a depth of 10 feet

Type of grout (circle one): Cement Bentonite Mix

Casing length: 81 feet Casing diameter: 16 inches Type of casing: PVC

Screen length: 40 feet Screen diameter: 16 inches Type of screen: PVC

Screen slot size: .050 inches Setting depth: From 82 feet to 121 feet

Type of completion (circle all applicable): Gravel packed Underreamed Telescoped Open hole Natural Development

Other (describe): _____

Top of lap pipe or reduction in casing: _____ feet. If telescoped or more than one screen, describe on back of page

Logs run (circle all applicable) No log run Electric Gamma Ray Density Sonic Neutron Other: _____

Name of organization running log(s): _____

I certify that the well was drilled, constructed, and completed in accordance with all applicable requirements of the Mississippi Department of Environmental Quality and/or the Mississippi Department of Health regulations and state laws.

Irrigation Equipment Inc
Patrick M. Chism 0695

Signature of Water Well Contractor: [Signature]

Print Name of Water Well Contractor and License No. _____

RECEIVED
JUL 18 2008
BY: OLWR

STATE WELL REPORT

Part 2

Pump Installer's Completion Report
 Mississippi Department of Environmental Quality
 Office of Land and Water Resources
 P.O. Box 10631
 Jackson, MS 39289-0631
 (601)961-5210
 (601)354-6938 (fax)

County: Leflore
 Permit #: CC-42681
 Irrigation Equipment
 Driller: _____
 Date completed: 7-3-08

For Office Use Only:

Aquifer: _____
 Well #: C-157
 Elevation: _____

This report should be prepared by the pump installer in detail and filed with the Department within 30 days of the installation of pump.

Well Owner Information	Well Location
Owner Name: <u>Buckhorn Plantation</u>	Latitude: _____ Longitude: _____
Mailing Address: <u>40 Aven Whittington</u>	Method of Lat/Long (circle one): Conventional Survey, USGS quad, Hand-held GPS, Survey-grade GPS
<u>P.O. Box 211</u>	<u>NW 1/4 SE 1/4 Sec 27 Twn 21N Rng 2W</u>
<u>Schlater Ms. 38952</u>	Distance Direction Nearest Town
City State Zip Code	<u>2 Miles NW of Schlater</u>
Telephone No. () _____	

Pump Type Circle one	Power Type Circle one
Air Lift Jet Submersible	<u>Diesel Engine</u> Gasoline Engine Natural Gas
Bucket Piston <u>Turbine</u>	Electric Motor Hand Tractor PTO
Centrifugal Rotary Flowing Well	Windmill Other (specify): _____
Other (specify): _____	Horse Power Rating of Motor: <u>60</u>
Date Pump Installed: <u>7-4-08</u>	Setting Depth: <u>70</u> feet
Rated Pump Capacity: <u>2800 ±</u> Gallons Per Minute	Number of Stages: <u>1</u>

Pump Test Data	Method of Measuring Water Level Circle one
Date Well Tested: _____	Air Line Electric Measuring Line Steel Tape
Static Water Level (A): _____ Feet Below Land Surface	Other (specify): _____
Pumping Water Level (B): _____ Feet Below Land Surface	For flowing well, measured shut in head: _____ feet
Drawdown [(B) - (A)]: _____ Feet Below Land Surface	Well yielded _____ GPM with a drawdown of _____
Test Pumping Rate: _____ Gallons Per Minute	_____ feet after _____ hours of pumping
Duration of Pump Test (minimum 4 hours): _____ hours	

I HEREBY CERTIFY that the above statements are true to the best of my knowledge.

Patrick M. Chism 0695
 Print Name of Pump Installer and License No. (if applicable)

[Signature]
 Signature of Pump Installer

RECEIVED
 JUL 18 2008
 BY: OLWR

