County:	Leflore
	GW-45913 √
Driller: Irrigation Equipment	
	02/24/2012

## State Well Report Part 1 - Driller's Log

Mississippi Department of Environmental Quality
Office of Land and Water Resources
P.O. Box 2309
Jackson, MS 39225
(601) 961-5210

(601) 961-5228 (fax)

For Office Use Only:		
Aquifer:	C 173	
Well #:		
L.S. Elev	ation:	
E-log#:		

State Law requires that this report be prepared by the license holder responsible for the work and filed with the Department at the above address within 30 days of completion of drilling of the well or borehole.

	epartment at the above address within 30 days	of completion of drilling of the well or borehole.
	Information on Well Owner	Well or Borehole Location
(Lando	wner if borehole is not for a water well)	
Owner Name	Buckhorn Farm Partners	Latitude: 33 ° 39 ' 15 " Longitude: 90 ° 22 ' 35 "
Mailing Address:	P.O. Box 9	Method of Lat/Long (check one):   Conventional Survey,
		☐ USGS quad, ☐ Hand-held GPS, ☐ Survey-grade GPS
	Schlater Ms 38952	NE ¼ SW ¼ Sec 26 ✓ Twn 21N ✓ Rng 2W
	City State Zip code	Distance Direction Nearest Town
Telephone No.	( ) -	2 Miles Northwest of Schlater
Well / Borehole Data		
Date drilling starte	d: 02/24/2012 Date drilling completed: 02/2	4/2012 Hole depth: 121 Hole diameter: 24"
	urce of any surface water used for drilling: Surface	
Method of dosing	and volume of Chlorine used in drilling and development	ent: 50 PPM
Logs run (check all applicable):  No log run  Electric  Gamma Ray  Density  Sonic  Neutron  Other:  Name of organization running log(s):		
Purpose of borehol	e (check one): Water Well Geotechnical	Geological Investigation Ground Source Heat Pump
	Seismic Survey Other (a	lescribe)
If drilling is not related to water well construction, skip the remainder of this block		
Purpose of Well (check one) ☐ Home ☐ Industrial ☐ Public Supply ☐ Irrigation ☐ Fish Culture ☐ Other:		
If flowing, method of flow regulation: Valve Other (describe)		
Static Water Level: 52 feet above or below (check one) □ land ☑ surface Date measured: 03/07/2012		
Method of Measurement (check one)   Steel tape □ electric tape □ air line □ other:		
Well depth: 121 Well grouted to a depth of 10 feet Type of grout (check one): Neat Cement Bentonite Mix		
Casing length: 81 feet Casing diameter: 16 inches Type of casing: PVC		
Screen length: 40 feet Screen diameter: 16 inches Type of screen: PVC		
Screen slot size:	.050 inches Setting depth: From	82 feet to 121 feet
Type of completion (check all applicable): Gravel packed Underreamed Telescoped Open hole Natural Development		
	Other (describe):	
Top of lap pipe or r	eduction in casing: feet. If t	elescoped or more than one screen, describe on next page

Form: OLWR-SWR-1A (04/08)

**RECEIVED** 

MAR 0 9 2012

BY: OLWR

## The sketch below only required for water wells

Ground level		 
		 •
	1	
	l	
	l	
	l	
	İ	
	ŀ	
	j	
	ŀ	
	ł	
	ļ	

<u>Description of formations encountered must be provided for all wells and boreholes, unless specifically exempted by regulations</u>

Description of Formations Encountered	From (depth)	To (depth)
Clay	Ground level	32
Fine Sand & Gravel	33	49
Medium Sand & Gravel	50	121

If more than one screen, show location of each on sketch

aid in	ayout and include the following: 1) the well location; 2) any permaner locating the well; 3) any roads, power lines, or other items that may a orth arrow.	nt structures on the property that may id in locating the property and the well;
4) 41	orur arrow.	
		i
Landowner Name:	Buckhorn Farm Partners	
I certify that the well/bo Mississippi Department laws.	rehole was drilled, constructed, and completed in accordance with all app of Environmental Quality and the Mississippi Department of Health regu	Form: OLWR-SWR-1A (04/08) licable requirements of the lations, if applicable, and state

Patrick Chism/Irrigation Equipment 0695 Print Name of Responsible Licensee and License No.

03/07/2012

RECEIVED

MAR 0 9 2012

BY: OLWR

## STATE WELL REPORT

## Part 2 Pump Installer's Completion Report

Mississippi Department of Environmental Quality Office of Land and Water Resources P.O. Box 2309 Jackson, MS 39225 (601) 961-5210

For Office Use Only:		
Aquifer:		
Well#: C173		
Elevation:		

Copy information from block on Part 1 (601) 961-5228 (fax)

This part of the report must be completed by a licensed water well contractor or a licensed pump installer. A copy of Part 1 of the


report must be attached and both parts filed with the Departmen	t at the above address within 30 days of well completion.	
Well Owner Information	Well Location	
Owner Name: Buckhorn Farm Partners	Latitude: 33 39' 15 N Longitude: 90 22' 35 W	
Mailing Address: P.O. Box 9	Method of Lat/Long (check one): Conventional Survey,	
	☐ USGS quad,   ☐ Hand-held GPS,   ☐ Survey-grade GPS	
Schlater Ms 38952	NE 1/4 SW 1/4 Sec 26 T 21N R 2W	
City State Zip code	Distance Direction Nearest Town	
Telephone No(	2 Miles Northwest of Schlater	
Pump Type Check one	Power Type Check one	
☐ Air Lift ☐ Jet ☐ Submersible	☐ Diesel Engine ☐ Gasoline Engine ☐ Natural Gas	
☐ Bucket ☐ Piston ☐ Turbine	☐ Electric Motor ☐ Hand ☐ Tractor PTO	
Centrifugal Rotary Flowing Well	☐ Windmill ☐ Other (specify):	
Other (specify):	Horse Power Rating of Motor: 60	
Date Pump Installed: 03/07/2012	Setting Depth: 80 feet	
Rated Pump Capacity 2500+/- Gallons Per Minute	Number of Stages: 1	
Pump Test Data	Method of Measuring Water Level Check one	
Date Well Tested:	☐ Air Line ☐ Electric Measuring Line ☐ Steel Tape	
Static Water Level (A): Feet Below Land Surface	Other (specify):	
Pumping Water Level (B): Feet Below Land Surface		
Drawdown [(B) - (A)]: Feet Below Land Surface	For flowing well, measured shut in head: feet	
Test Pumping Rate: Gallons Per Minute	Well yielded GPM with a drawdown of	
Duration of Pump Test (minimum 4 hours): hours	feet after hours of pumping	
This is for (check one): New Well Replacem	nent of Existing Pump Repair of Existing Pump	
Patrick Chism/Irrigation Equipment 0695 Print Name of Pump Installer and License No. (if applicable)  RECEIVED Signature of Pump Installer		
	Form Oliving and 12 (47-09)	

County: Leflore

Permit #: GW-45913

Driller: Irrigation Equipment

Date drilling completed: 02/24/2012

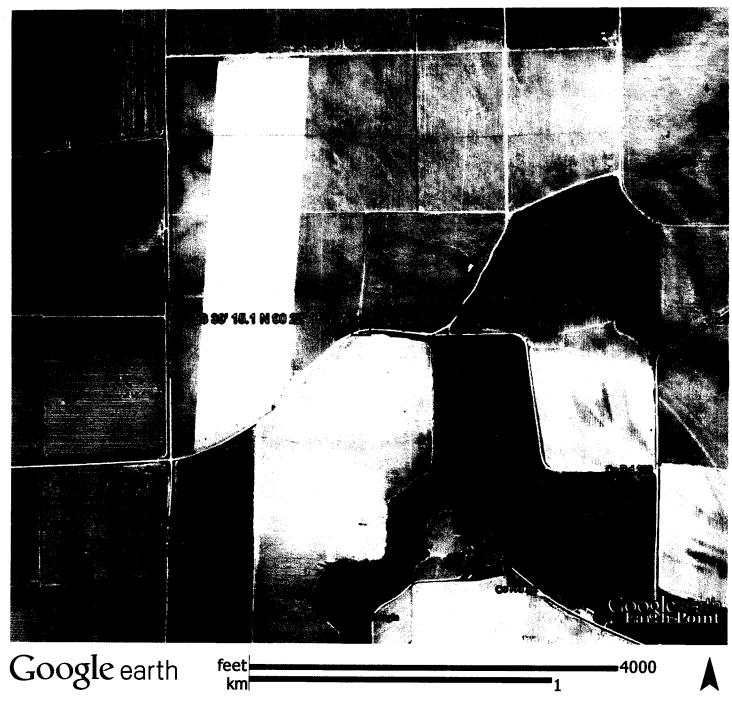

**RECEIVED** 

MAR 0 9 2012

BY: OLWR