County:	Leflore
	GW-46111 √
Driller:	Irrigation Equipment
Date drilli	ing completed: 04/21/2012

State Well Report Part 1 – Driller's Log

Mississippi Department of Environmental Quality
Office of Land and Water Resources
P.O. Box 2309
Jackson, MS 39225
(601) 961-5210


(601) 961-5228 (fax)

Aquifer:	C 177	
Well #:		
L.S. Elevat	ion:	
E-log #: _		

State Law requires that this report be prepared by the license holder responsible for the work and filed with the Department at the above address within 30 days of completion of drilling of the well or borehole.

<i>D</i>	Information on Well Owner	Well or Borehole Location
(Lando)	vner if borehole is not for a water well)	
Owner Name	James Beckum Jr.	Latitude: 33 ° 43 ' 08 " Longitude: 90 ° 21 ' 57 '
Mailing Address:	3506 County Road 522	Method of Lat/Long (check one): Conventional Survey,
		☐ USGS quad, ☐ Hand-held GPS, ☐ Survey-grade GPS
	Minter City Ms 38944	NE 1/4 NE 1/4 Sec 2 Twn 21N Rng 2W
	City State Zip code	SE. Distance Direction Nearest Town
Telephone No.	() -	4 Miles Southwest of Minter City
	Well / Be	orehole Data
Date drilling starte	d: 04/21/2012 Date drilling completed: 04/2	21/2012 Hole depth: 119 Hole diameter: 24"
Location of the sou	arce of any surface water used for drilling: Surface	: Water
	and volume of Chlorine used in drilling and developm	
Logs run (check al Name of organizat	ion running log(e):	a Ray Density Sonic Neutron Other:
Purpose of borehol	e (check one): Water Well Geotechnical	I/Geological Investigation Ground Source Heat Pump
	Seismic Survey Other (describe)
	, _ ,	onstruction, skip the remainder of this block
Purpose of Well (c	heck one) 🔲 Home 🔲 Industrial 🔲 Public Sup	pply ☑ Irrigation ☐ Fish Culture ☐ Other:
If flowing, method	of flow regulation: Valve Other (de:	scribe)
Static Water Level	feet above or below (check one) 🗆 lar	nd ⊠ surface Date measured: 04/23/2012
Method of Measure	ement (check one) 🛮 steel tape 🔲 electric tape	□ air line □ other:
Well depth: 119	Well grouted to a depth of feet	Type of grout (check one): ☐ Neat Cement ☒ Bentonite ☐ Mix
Casing length: _7	feet Casing diameter: 16	inches Type of casing: PVC
Screen length: 4	feet Screen diameter: 16	inches Type of screen: PVC
Screen slot size:	.050 inches Setting depth: From	80 feet to 119 feet
Type of completion	ı (check all applicable): 🛛 Gravel packed 🔲 U	Inderreamed Telescoped Open hole Natural Development
	Other (describe):	
Top of lap pipe or r	reduction in casing: feet. If	telescoped or more than one screen, describe on next page

Form: OLWR-SWR-1A (04/08)

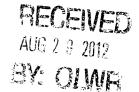

If well	telescopes,	show	depths	on	<u>sketch.</u>

Ground level	

Description of formations encountered	ed must be provided for all
wells and boreholes, unless specifical	lly exempted by regulations

Description of Formations Encountered	From (depth)	To (depth)
Clay	Ground level	29
Fine Sand	30	42
Fine Sand & Gravel	43	53
Medium Sand & Gravel	54	117
Clay	118	119

ii more dian one	solven, show location of cach on sa	Cicii		
aid	ty layout and include the foll d in locating the well; 3) any a north arrow.	owing: 1) the well location roads, power lines, or oth	on; 2) any permanent structure er items that may aid in locat	es on the property that may ing the property and the well;
Landowner Name:	James Beckum Jr.			
I certify that the well	/horehole was drilled constru	ested and completed in occ	ordance with all applicable req	Form: OLWR-SWR-1A (04/08)
Mississippi Departm	ent of Environmental Quality	and the Mississippi Depart	ment of Health regulations, if	applicable, and state
laws. Patrick Chism	0695	08/22/2012		
Print Name of Responsible		Date	Signature of Licensee	
				RECEIVED

AUG 2 2 2017 BY OLMA

STATE WELL REPORT

Part 2 **Pump Installer's Completion Report**


Mississippi Department of Environmental Quality Office of Land and Water Resources P.O. Box 2309 Jackson, MS 39225 (601) 961-5210 (601) 961-5228 (fax)

For Office Use Only:		
Aquifer:		
Well #:	***************************************	
Elevation:		

Permit #: **GW-461**11 Driller: Irrigation Equipment Date drilling completed: 04/21/2012Copy information from block on Part 1

County: Leflore

report must be	attached and both parts Well Owner Inform		t at the above address within 30 days of well completion. Well Location
		iation	
Owner Name: James Beckum Jr.			Latitude: 33 43' 08.6 N Longitude: 90 21' 57.6 W
Mailing Address:	3506 County Road 5	22	Method of Lat/Long (check one): Conventional Survey,
	 		☐ USGS quad, ☐ Hand-held GPS, ☐ Survey-grade GPS
	Minter City	Ms 38944	NE 1/4 NE 1/4 Sec 2 T 21N R 2W
	City	State Zip code	Distance Direction Nearest Town
Telephone No.	() -		4 Miles Southwest of Minter City
	Pump Type Check one		Power Type Check one
☐ Air Lift	☐ Jet	Submersible	☑ Diesel Engine ☐ Gasoline Engine ☐ Natural Gas
Bucket	☐ Piston	□ Turbine	☐ Electric Motor ☐ Hand ☐ Tractor PTO
Centrifugal	Rotary	Flowing Well	☐ Windmill ☐ Other (specify):
Other (specify):			Horse Power Rating of Motor: 60
Date Pump Installed: 04/23/2012			Setting Depth: 70 feet
Rated Pump Capac	eity 2500+/-	Gallons Per Minute	Number of Stages: 1
	Pump Test Dat	a	Method of Measuring Water Level Check one
Date Well Tested:			
		Feet Below Land Surface Feet Below Land Surface	Other (specify):
		Feet Below Land Surface	For flowing well, measured shut in head: feet
	::		Well yielded GPM with a drawdown of
Duration of Pump	Test (minimum 4 hours):	hours	feet after hours of pumping
This is for (c	heck one):	.W-II	
			nent of Existing Pump Repair of Existing Pump
I HEREBY CERT	IFY that the above statem	ents are true to the best of m	y knowledge.)
Print Name of Pump Installer and License No. (if applicable)			PECEIVE
rim Name of Pt	ump installer and License	No. (if applicable)	Signature of Pump Installer Form: OLWR-SWR-1C-(97-09)

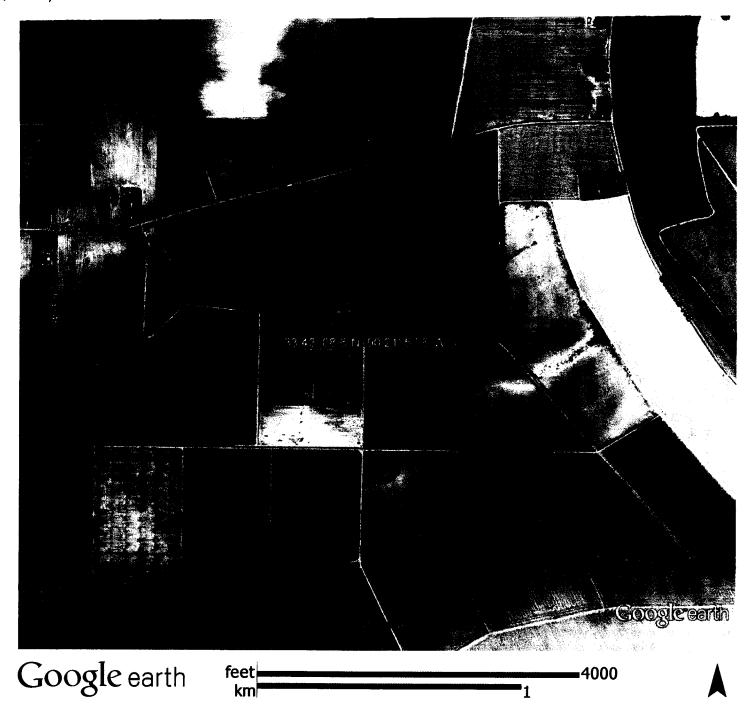

AUG 2 9 2012 BY: OLWR