

State Well Report

Part I

Mississippi Department of Environmental Quality
Office of Land and Water Resources
P.O. Box 10631
Jackson, MS 39289-0631
(601)961-5210
(601)354-6938 (fax)

County: Leflore
Permit #: OW41789
Irrigation Equipment
Driller: _____
Date drilling completed: 5-16-07

For Office Use Only:
Aquifer: C191
Well #: F 182
L. S. Elevation: _____
E-log #: _____

State Law requires that this report be prepared by the driller in detail and filed with the Department within 30 days of completion of drilling of the well.

Well Owner Information	Well Location
Owner Name: <u>Tackett Fish Farm</u>	Latitude: <u>33° 31' 08.9"</u> Longitude: <u>90° 26' 53.1"</u>
Mailing Address: <u>23939 CR 523</u>	Method of Lat/Long (circle one): Conventional Survey, <u>39 30 15</u>
<u>Schlater Ms. 38952</u>	USGS quad, Hand-held GPS, Survey-grade GPS
City State Zip Code	<u>SW 1/4 Sec 19 Twn 20N Rng 2 W</u>
Telephone No. ()	Distance Direction Nearest Town
	<u>6 Miles SW of Schlater</u>

Well Data

Purpose of Well (circle one) Home Industrial Public Supply Irrigation Fish Culture Other: replacement

Date well drilling started: 5-16-07 Date well drilling completed: 5-16-07

If flowing, method of flow regulation: Valve _____ Other (describe) _____

Static Water Level: 40 feet above or below (circle one) land surface Date measured: 5-16-07

Method of Measurement (circle one) steel tape electric tape air line other: _____

Hole depth: 121 Well depth: 121 Well grouted to a depth of 10 feet

Type of grout (circle one): Cement Bentonite Mix

Casing length: 81 feet Casing diameter: 16 inches Type of casing: PVC Sch 40

Screen length: 40 feet Screen diameter: 16 inches Type of screen: PVC Sch 40

Screen slot size: .050 inches Setting depth: From 82 feet to 121 feet

Type of completion (circle all applicable): Gravel packed Underreamed Telescoped Open hole Natural Development

Other (describe): _____

Top of lap pipe or reduction in casing: _____ feet. If telescoped or more than one screen, describe on back of page

Logs run (circle all applicable): No log run Electric Gamma Ray Density Sonic Neutron Other: _____

Name of organization running log(s): _____

I certify that the well was drilled, constructed, and completed in accordance with all applicable requirements of the Mississippi Department of Environmental Quality and/or the Mississippi Department of Health regulations and state laws.

Irrigation Equipment Inc.
Patrick M. Chism 0695

Patrick M. Chism

Print Name of Water Well Contractor and License No.

Signature of Water Well Contractor

GW41789

C191 ~~F-182~~

If well telescopes please sketch below and show depths.

Ground Level

Description of Formations Encountered	From	To
Clay	0	17
Clay	18	27
Clay	28	37
Course Sand Peg Gravel	38	47
Course Sand Peg Gravel	48	57
Course Sand Peg Gravel	58	67
Course Sand Peg Gravel	68	77
Course Sand Gravel	78	87
Course Sand + Peg Gravel	88	97
Course Sand + Rock	98	107
Course Sand + Rock	108	117
Course Sand + Gravel	118	121
Hard Sand Stone	121	

If more than one screen, show location of each on sketch

Sketch the property layout and include the following: 1) the well location; 2) any permanent structures on the property that may aid in locating the well; 3) any roads, power lines, or other items that may aid in locating the property and the well; 4) indicate direction.

Landowner Name: Tackett Fish Farm

Signature of Water Well Contractor

STATE WELL REPORT

Part 2

Pump Installer's Completion Report
 Mississippi Department of Environmental Quality
 Office of Land and Water Resources
 P.O. Box 10631
 Jackson, MS 39289-0631
 (601)961-5210
 (601)354-6938 (fax)

County: Leflore
 Permit #: 6W41789
 Irrigation Equipment
 Driller: _____
 Date completed: 5-16-07

For Office Use Only:

Aquifer: C191
 Well #: F-102
 Elevation: _____

This report should be prepared by the pump installer in detail and filed with the Department within 30 days of the installation of pump.

Well Owner Information	Well Location
Owner Name: <u>Tackett Fish Farm</u>	Latitude: _____ Longitude: _____
Mailing Address: <u>23939 CR 523</u>	Method of Lat/Long (circle one): <input type="checkbox"/> Conventional Survey, <input type="checkbox"/> USGS quad, <input type="checkbox"/> Hand-held GPS, <input type="checkbox"/> Survey-grade GPS
<u>Schlater Ms. 38952</u> <small>City State Zip Code</small>	<u>NW ¼ SE ¼ Sec 19 Twn 20N Rng 2W</u>
Telephone No. () _____	Distance Direction Nearest Town <u>6 Miles SW of Schlater</u>

Pump Type Circle one	Power Type Circle one
Air Lift Jet Submersible	Diesel Engine Gasoline Engine Natural Gas
Bucket Piston <u>Turbine</u>	<u>Electric Motor</u> Hand Tractor PTO
Centrifugal Rotary Flowing Well	Windmill Other (specify): _____
Other (specify): _____	Horse Power Rating of Motor: <u>60</u>
Date Pump Installed: <u>5-16-07</u>	Setting Depth: <u>80</u> feet
Rated Pump Capacity: <u>2300±</u> Gallons Per Minute	Number of Stages: <u>2</u>

Pump Test Data	Method of Measuring Water Level Circle one
Date Well Tested: _____	Air Line Electric Measuring Line Steel Tape
Static Water Level (A): _____ Feet Below Land Surface	Other (specify): _____
Pumping Water Level (B): _____ Feet Below Land Surface	For flowing well, measured shut in head: _____ feet
Drawdown [(B) - (A)]: _____ Feet Below Land Surface	Well yielded _____ GPM with a drawdown of _____ feet after _____ hours of pumping
Test Pumping Rate: _____ Gallons Per Minute	
Duration of Pump Test (minimum 4 hours): _____ hours	


I HEREBY CERTIFY that the above statements are true to the best of my knowledge.

Patrick M. Chism 0695 Patrick M. Chism
 Print Name of Pump Installer and License No. (if applicable) Signature of Pump Installer

6W41789

C191 F-182

Tackett Fish Farm

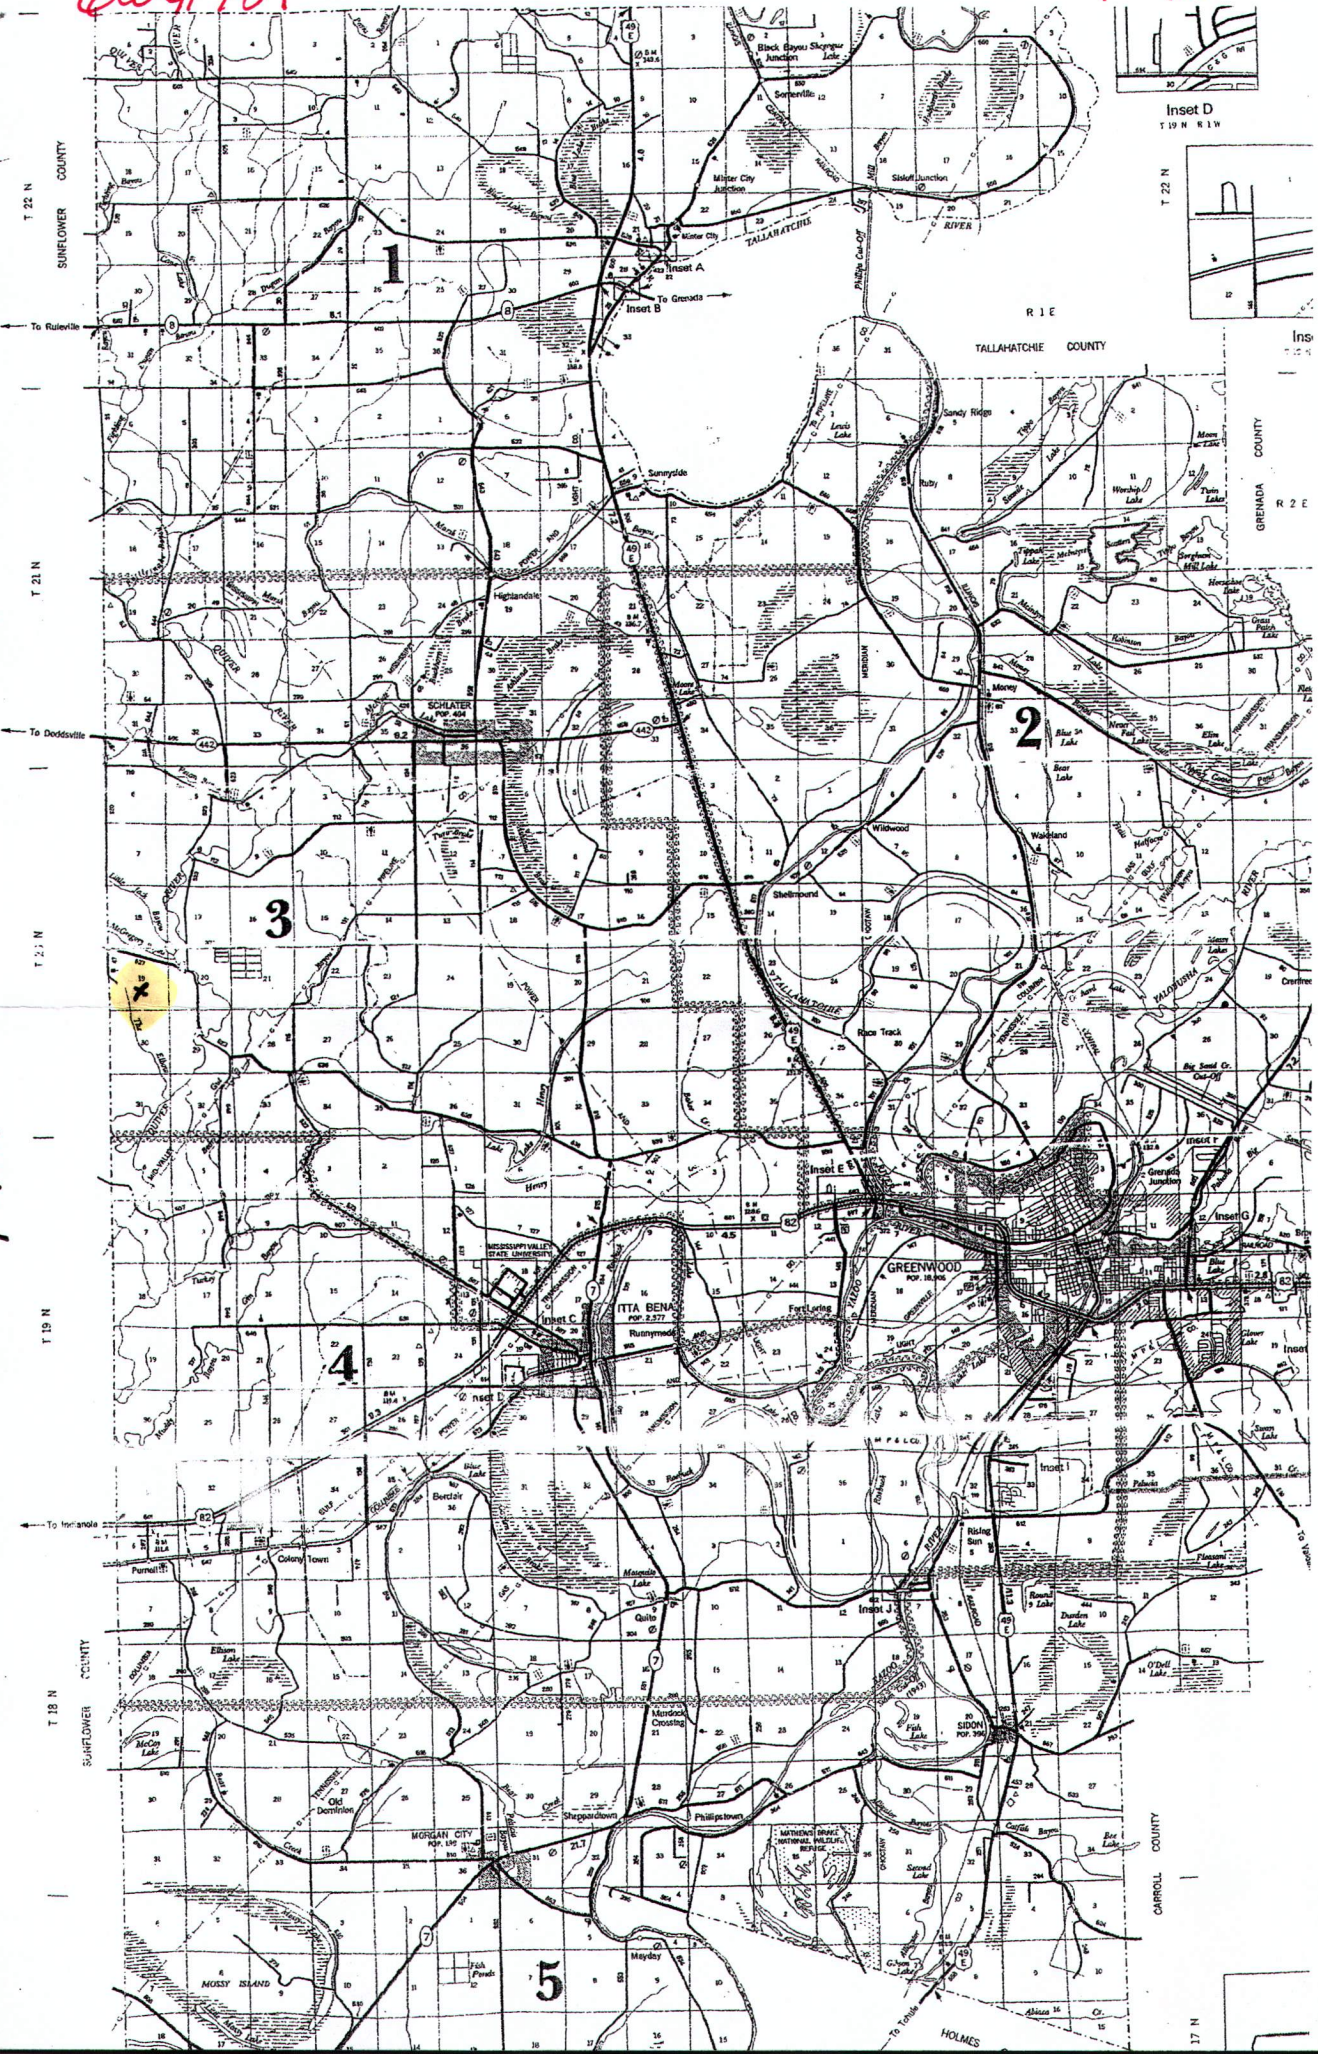

Vertical scale and grid information on the left margin, including township labels (T. 22 N., T. 21 N., T. 20 N., T. 19 N., T. 18 N.) and range labels (R. 1 E., R. 2 E., R. 3 E., R. 4 E.).