

WATER WELL DRILLERS LOG

9/28/65

MC 432

Date: June 11, 1957, Driller: Layne-Central Company County Leflore
 (Name)

(1) Owner of Land: June Broadway
 (Name)
Greenwood, Mississippi
 (Address)

(2) Location: 1/4, 1/4, Sec. T R
6 miles southwest of Minter City
 (distance) (direction) (Nearest Town)

(3) Topography: flat
 (Hilly) (Flat) (Level)

(4) Purpose of Well: domestic
 (Domestic Irrigation
 Municipal, Industrial, Other)

Description & Color of Materials Sand, Clay, Red Clay, Shell, etc.	Thick- ness Feet	Depth Feet
Clay	26	26
Fine sand	7	33
Coarse sand	17	50
Coarse sand & pea gravel	57	107
Rock	1	108
Coarse sand & pea gravel	27	135
Coarse sand	21	156
Sand rock	2	158
Clay	5	163
Sand	5	168
Shale	79	247
Coarse sand	133	380
Sand & strks. of shale	15	395
Shale	50	445
Sand rock	3	448
Sand	8	456
Shale	79	535
Sand rock	3	536
Shale	16	554
Sand rock	10	556
Shale	21	580
Sand rock	2	582
Shale	188	770
Sand, strks. of shale	15	785
Shale	5	790
Shale, strks. of sand	70	860
Gummy clay	57	917
Sand	5	922
Sand, strks. of shale (bottom)	52	974

Information upon completion of well:

(1) Diameter 3 inches.

(2) Total Depth 974 feet.

(3) Water Level flowing feet below top of ground.

(4) Cased to 936', Size 3"
11' of 3" blank

(5) Screen: Size 3", Length 30'
3 1/2' bottom slugs


(6) Were any formations sealed against pollution?
yes yes, no no.

If YES depth of formation Packer above
 the screen and metal bottom.
 Why _____

Drillers Remarks: _____

25 GPM.

Flowing well.

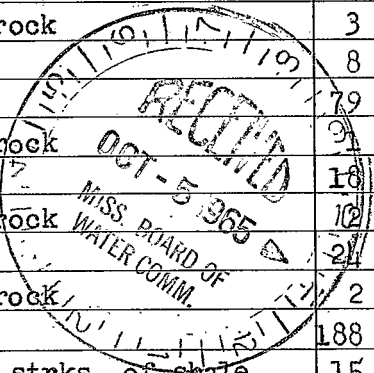

(Use Back Side)

Well No.

