

LEFLORE

C.

4/2/79

1053

MISSISSIPPI BOARD OF WATER COMMISSIONERS 416 North State Street Jackson, Mississippi 39201

CODED

WATER WELL DRILLERS LOG

BUTANE GAS COMPANY OF GREENWOOD

Leflore

4-2-79 19 date well completed

county well located

LANDOWNER:	description of formations encountered	from	to
CONWAY FARMS			
Ida Beal	Brown Clay	10	34
(mailing address)	SAND	34	48
WELL LOCATION:	SAND + Pea Gravel	48	60
sec. 3 T. 21 N. R. 2 E	SAND + GRAVEL	60	90
6 1/2 miles SW of Menden City	ROCK		
(distance) (direction) (nearest town)			
WELL PURPOSE: F.A.R.			
(home, irrigation, municipal, industrial)			
WELL COMPLETION DATA:			
(1) diameter (inches) 16"			
(2) total depth (feet) 90'			
(3) static water level (feet) 18' below top of ground.			
(4) casing Steel 50' (material) (depth)			
16" If telescope see back. (size)			
(5) screen 40' 50' (length) (depth to top)			
16" Steel (size) (material)			
(6) pump 80 3000 (HP) (yield gpm)			
Diesel (type power)			
(7) electric log NO (yes or no)			
(organization running log)			
(8) how well bottom plugged Steel 1/2" (material)			
DRILLERS REMARKS:			

CODED


Miss. Board of Water Commrs

APR 28 1979

RECEIVED

If well telescopes please sketch and show depths.

GROUND LEVEL

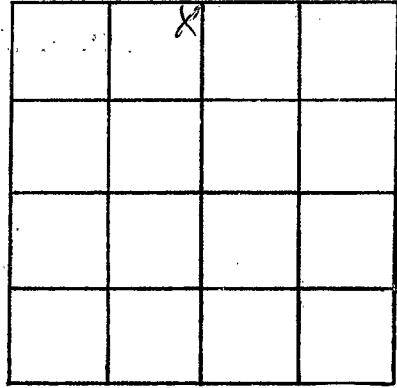

SECTION 3

Please indicate well location X.

ADDITIONAL INFORMATION

If more than one screen, show locations of each on sketch.