

MISSISSIPPI DEPARTMENT OF NATURAL RESOURCES

Bureau of Land and Water Resources

Southport Mall

P.O. Box 10631

CODED

Jackson, Mississippi 39209

WATER WELL DRILLERS LOG

Leflore
C
6-23-81

1082

6-23 1981
 date well completed

8/BUTANE GAS COMPANY
OF GREENWOOD

Leflore
 county well located

LANDOWNER: Dewitt Corp.
Schlater, Mo.
 (mailing address)

description of formations encountered	from	to
<u>CLAY</u>	<u>0</u>	<u>26</u>
<u>SAND & Pea Gravel</u>	<u>26</u>	<u>50</u>
<u>SAND</u>	<u>50</u>	<u>57</u>
<u>SAND & Gravel</u>	<u>57</u>	<u>77</u>
<u>CLAY</u>	<u>77</u>	<u>80</u>

WELL LOCATION:
 sec. 20 T 21 N R 2 E
4.5 miles NW of Schlater
 (distance) (direction) (nearest town)

WELL PURPOSE: irrigation
 (home, irrigation, municipal, industrial).

WELL COMPLETION DATA:

(1) diameter (inches) 16"

(2) total depth (feet) 80

(3) static water level (feet) 25 ^{below} _{above} top of ground.

(4) casing Steel, 40'
 (material) (depth)
16" if telescope see back.
 (size)

(5) screen 40', 40
 (length) (depth to top)
16", Steel
 (size) (material)

(6) pump 60 3000
 (HP) (yield gpm)
Diesel
 (type power)

(7) electric log _____
 (yes or no)

 (organization running log)

(8) how well bottom plugged Steel Plate

CODED

DEPT. OF NATURAL RESOURCES
 BUREAU OF LAND & WATER RESOURCES


JUL - 2 1981

RECEIVED

DRILLERS REMARKS:

If well telescopes please
sketch and show depths.

GROUND LEVEL

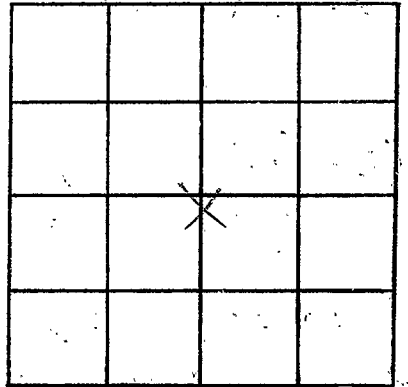

SECTION 20

Please indicate well location X.

ADDITIONAL INFORMATION

If more than one screen,
show locations of each on sketch.