

LEFLORE

MISSISSIPPI
BOARD OF WATER COMMISSIONERS
416 North State Street
Jackson, Mississippi 39201

WATER WELL DRILLERS LOG
BUTANE GAS COMPANY
OF GREENWOOD

Leflore
county well located

C 2001
6/27/78

6-27-78
date well completed

LANDOWNER:

Loyd Hodges

Winter City
(mailing address)

WELL LOCATION:

sec. 9 T. 21 N. R. 2 E. S. W.
5 miles W of Sunny Side
(distance) (direction) (nearest town)

WELL PURPOSE: Home
(home, irrigation, municipal, industrial)

WELL COMPLETION DATA:

- (1) diameter (inches) 4"
 - (2) total depth (feet) 80
 - (3) static water level (feet) 27 below above top of ground.
 - (4) casing PVC 70 (material) (depth) 4" (size) if telescope see back.
 - (5) screen 10 70 (length) (depth to top) 4" PVC (size) (material)
 - (6) pump 1/2 10 (HP) (yield gpm) Elec (type power)
 - (7) electric log N/S (yes or no)
- (organization running log)

(8) how well bottom plugged
Back Pressure Valve

DRILLERS REMARKS:


description of formations encountered	from	to
CLAY	0	30
SAND	30	45
SAND + PEA GRAVEL	45	60
SAND + GRAVEL	60	83

RECEIVED
JUL 7 1978

MISS. BD. OF WATER COMMISSIONERS

If well telescopes please sketch and show depths.

GROUND LEVEL

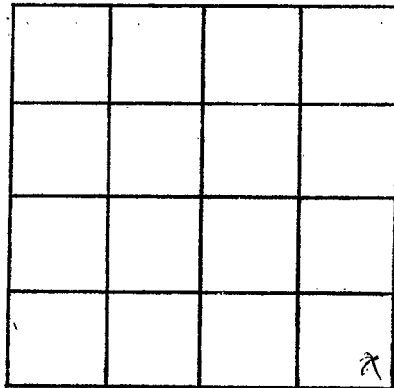

SECTION 7

Please indicate well location X.

ADDITIONAL INFORMATION

A series of horizontal lines for recording additional information.

If more than one screen, show locations of each on sketch.