

MISSISSIPPI DEPARTMENT OF NATURAL RESOURCES

Bureau of Land and Water Resources

COUNTY WELL LOCATED
LeFlore

WELL NUMBER CODED
C 9005

DATE WELL COMPLETED
4-19-94

PERMIT NUMBER

NAME OF DRILLING FIRM
HOUSTON DRILLING INC

P.O. Box 10631
Jackson, Mississippi 39209
WATER WELL DRILLERS LOG

NAME & MAILING ADDRESS OF LANDOWNER
T. C. Bitt

WELL LOCATION: SEC **2** TOWNSHIP **21** RANGE **2**

Minter City DISTANCE **4** Miles DIRECTION **W** of NEAREST TOWN **Minter City**

OTHER LANDMARK

WELL PURPOSE: Home, Irrigation, Municipal, Industrial, Fish Pond, etc.
Irrigation

PUMP DATA

PUMP TYPE (Circle One):
Submersible, Turbine, Jet, Flowing Well,
Other (Describe) _____

POWER TYPE (Circle One):
Electric, Tractor, Diesel, Gasoline, Butane,
Other (Describe) _____ H/P _____

Pump Capacity (GPM) 2200	No. of Stages 2	Setting Depth 60 FT.
------------------------------------	---------------------------	--------------------------------

PUMP TEST

Well yielded **2200** GPM with
a drawdown of _____ ft.
after _____ hours of pumping

WELL DATA

Well Depth 106'	Casing Diameter (In.) 16"	Casing Length (Ft.) 66'
Type of Casing Steel	Hole Depth 106'	Depth to Static Water Level

TYPE OF COMPLETION: (Circle One or More):
 Gravel Packed, Underreamed, Telescoped,
 Natural Development, Open Hole, Other

Top of Lap Pipe or Reduction in Casing

FEET IF TELESCOPED OR MORE THAN ONE SCREEN: USE BACK PAGE

LOG DATA

TYPE OF LOG RUN (Circle One):
No Log Run, Electric, Gamma Ray, Density, Sonic, Neutron,
Other (Describe) _____

Name of Organization Running Log

SCREEN DATA

Diameter - Inches 16"	Length - Feet 40'	Slot Size - Inches
Screen Type Wire Wrapped	Depth to Bottom - Feet 106	

RECEIVED
GEOLOGIC DATA (Office Use Only)

Surface Elev.	Geologic Unit	Unit Thickness	Depth to Top
Subs. SW	Date	Analysis	Aquifer Test


Driller's Remarks **AUG 11 1994**

**Dept. of Environmental Quality
Office of Land & Water Resources**

DESCRIPTION OF FORMATIONS ENCOUNTERED	FROM	TO	FORMATIONS (Continued)	FROM	TO
clay	0	10			
clay	10	20			
clay & sand	20	30			
sand & gravel	30	40			
gravel	40	50			
gravel	50	60			
gravel	60	70			
gravel	70	80			
gravel	80	90			
gravel	90	100			
gravel	100	106			

IF MORE SPACE IS NEEDED, USE BACK

scopes please
show depths.

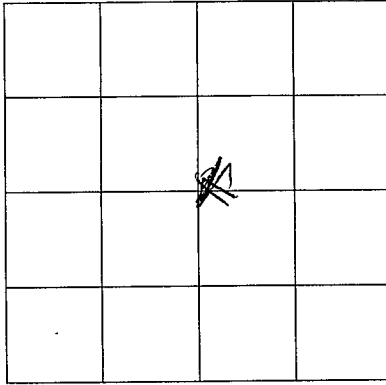

SECTION _____

Please indicate well location X.

ADDITIONAL INFORMATION

one screen,
of each on sketch.