

MISSISSIPPI DEPARTMENT OF ENVIRONMENTAL QUALITY

Office of Land and Water Resources

COUNTY, WELL LOCATED Leflore	
WELL NUMBER <u>C-2008</u>	CODED
DATE WELL COMPLETED 10-22-97	

PERMIT NUMBER
NAME OF DRILLING FIRM Irrigation Equipment Inc.
Indianola, MS

P. O. Box 10631
Jackson, MS 39289-0631
WATER WELL DRILLERS LOG

NAME & MAILING ADDRESS OF LANDOWNER H. Reed Carroll 1303 River Rd. Greenwood, MS 38930			
WELL LOCATION:	SEC	TOWNSHIP	RANGE
	33	21N S	2W W
DISTANCE	DIRECTION	NEAREST TOWN	
8 Miles	West	Minter City of	
OTHER LANDMARK			
WELL PURPOSE: Home Irrigation, Municipal, Industrial, Fish Pond, etc.			

PUMP DATA		
PUMP TYPE (Circle One): <u>Submersible</u> , Turbine, Jet, Flowing Well, Other (Describe) _____		
POWER TYPE (Circle One): <u>Electric</u> , Tractor, Diesel, Gasoline, Butane, Other (Describe) _____ H/P <u>20</u>		
Pump Capacity (GPM)	No. of Stages	Setting Depth
1000	1	60 FT.
PUMP TEST		
Well yielded _____ GPM with a drawdown of _____ ft. after _____ hours of pumping		

WELL DATA		
Well Depth	Casing Diameter (In.)	Casing Length (Ft.)
117	10	77
Type of Casing	Hole Depth	Depth to Static Water Level
PVC	117	

LOG DATA	
TYPE OF LOG RUN (Circle One): <u>Gravel Packed</u> , No Log Run, Electric, Gamma Ray, Density, Sonic, Neutron, Other (Describe) _____	
Name of Organization Running Log	

TYPE OF COMPLETION: (Circle One or More):
Gravel Packed, Underreamed, Telescoped,
Natural Development, Open Hole, Other

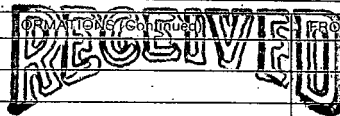
GEOLOGIC DATA (Office Use Only)			
Surface Elev.	Geologic Unit	Unit Thickness	Depth to Top
Subs. SWL	Date	Analysis	Aquifer Test

WELL GROUTED TO A DEPTH OF _____ FEET
Type Grout (circle one): Cement, Bentonite, or Mix

Driller's Remarks	
Top of Lap Pipe or Reduction in Casing	
FEET	IF TELESCOPED OR MORE THAN ONE SCREEN: USE BACK PAGE

SCREEN DATA		
Diameter - Inches	Length - Feet	Slot Size - Inches
10	40	.050
Screen Type	Depth to Bottom - Feet	
PVC	117	

DESCRIPTION OF FORMATIONS ENCOUNTERED	FROM	TO
Clay	0	25
Fine Sand	25	35
Fine Sand & Gravel	35	55
Med. Sand & Gravel	55	117

 DEC 08 1997 Dept. of Environmental Quality Office of Land & Water Resources		
IF MORE SPACE IS NEEDED, USE BACK		

If well telescopes please
sketch and show depths.

GROUND LEVEL

			X

SECTION 33

Please indicate well location X.

ADDITIONAL INFORMATION

If more than one screen,
show location of each on sketch.