

MISSISSIPPI DEPARTMENT OF ENVIRONMENTAL QUALITY

Office of Land and Water Resources

P. O. Box 10631
Jackson, MS 39289-0631
WATER WELL DRILLERS LOG

COUNTY WELL LOCATED Leflore	
WELL NUMBER C 2010	CODED
DATE WELL COMPLETED 11-25-98	

PERMIT NUMBER
NAME OF DRILLING FIRM IRRIGATION EQUIPMENT
601/887-2555

NAME & MAILING ADDRESS OF LANDOWNER Tackett Fish Farm			
Rt. 1, Box 187			
Schlater, MS 38952			
WELL LOCATION:	SEC	TOWNSHIP	RANGE
SE/NE	21	21	2
DISTANCE	DIRECTION	NEAREST TOWN	
4 Miles	NW	of Schlater	
OTHER LANDMARK			
WELL PURPOSE: Home, Irrigation, Municipal, Industrial, Fish Pond, etc. Fish Pond			

PUMP DATA		
PUMP TYPE (Circle One): Submersible, (Turbine) Jet Flowing Well, Other (Describe) _____		
POWER TYPE (Circle One): (Electric) Tractor, Diesel, Gasoline, Butane, Other (Describe) _____ H/P 40		
Pump Capacity (GPM) 2000	No. of Stages 2	Setting Depth 70 FT.
PUMP TEST		
Well yielded _____ GPM with a drawdown of _____ ft. after _____ hours of pumping		

WELL DATA		
Well Depth 135	Casing Diameter (In.) 16	Casing Length (Ft.) 95
Type of Casing PVC	Hole Depth 135	Depth to Static Water Level 46 Ft.
TYPE OF COMPLETION: (Circle One or More): (Gravel Packed) Underreamed, Telescoped, Natural Development, Open Hole, Other (Describe) _____		
WELL GROUTED TO A DEPTH OF _____ FEET Type Grout (circle one): Cement, Bentonite, or Mix		

LOG DATA	
TYPE OF LOG RUN (Circle One): No Log Run, Electric, Gamma Ray, Density, Sonic, Neutron, Other (Describe) _____	
Name of Organization Running Log	

SCREEN DATA		
Diameter - Inches 16	Length - Feet 40	Slot Size - Inches 1050
Screen Type PVC	Depth to Bottom - Feet 135	

GEOLOGIC DATA (Office Use Only)			
Surface Elev.	Geologic Unit	Unit Thickness	Depth to Top
Subs. SWL	Date	Analysis	Aquifer Test
Driller's Remarks			
Top of Lap Pipe or Reduction in Casing			
FEET			
IF TELESCOPED OR MORE THAN ONE SCREEN: USE BACK PAGE			

DESCRIPTION OF FORMATIONS ENCOUNTERED	FROM	TO
CLAY	0	30
FINE SAND	30	50
MED. SAND + GRAVEL	50	100
COARSE SAND + GRAVEL	100	135

FORMATIONS (Continued)	FROM	TO
RECEIVED		
DEC 17 1998		
Dept. of Environmental Quality Office of Land & Water Resources		
IF MORE SPACE IS NEEDED, USE BACK		

If well telescopes please
sketch and show depths.


GROUND LEVEL

			X

SECTION 21

Please indicate well location X.

ADDITIONAL INFORMATION

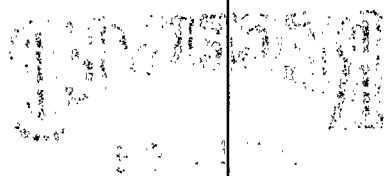

If more than one screen,
show location of each on sketch.