

Leflore MISSISSIPPI BOARD OF WATER COMMISSIONERS

D  
12-10-58

WATER WELL DRILLERS LOG

11/12/65  
2615

Date: Dec. 10, 1958, Driller: Layne-Central Company County Leflore

(Name)

(1) Owner of Land: **Hobart Key, Jr.**  
(Name)

**Minter City, Mississippi**  
(Address)

(2) Location: \_\_\_\_\_ 1/4, \_\_\_\_\_ 1/4, Sec. \_\_\_\_\_ T \_\_\_\_\_ R \_\_\_\_\_

4 miles **south**, of **Minter City**  
(distance) (direction) (Nearest Town)

(3) Topography: **flat**  
(Hilly) (Flat) (Level)

(4) Purpose of Well: **domestic**  
(Domestic Irrigation  
Municipal, Industrial, Other)

Information upon completion of well:

(1) Diameter 3 inches.

(2) Total Depth 954 feet.

(3) Water Level flowing feet below top of ground.

(4) Cased to 913', Size 3",  
10' blank 3"

(5) Screen: Size 3", Length 31'

(6) Were any formations sealed against pollution?

yes yes, \_\_\_\_\_ no.


If YES depth of formation Packer above the screen and lead shot bottom.

Why \_\_\_\_\_

Drillers Remarks: \_\_\_\_\_

25 GPM.

Description & Color of Materials Sand, Clay, Red Clay, Shell, etc.	Thick- ness Feet	Depth Feet
Clay	7	7
Sandy clay	7	14
Fine sand	16	30
Coarse sand	25	55
Coarse sand & pea gravel	35	90
Coarse sand & cemented gravel	51	141
White sand	24	165
Clay	8	173
Sand with strks. clay	57	230
Clay	15	245
Sandy shale	70	315
Sand	25	340
Shale	82	422
Rock	1	423
Hard shale	45	468
Sandy shale	50	518
Rock	1	519
Shale	51	570
Shale & clay	170	740
Sandy shale	90	830
Clay	67	897
Sand & shale	10	907
Sand	46	953
Clay (bottom)	1	954

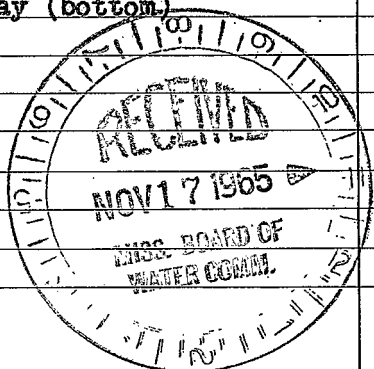

(Use Back Side)

Well No.

...the ... of ...

...the ... of ...

