

LEFLORE
D 5
4-28-71

MISSISSIPPI
 BOARD OF WATER COMMISSIONERS
 416 North State Street
 Jackson, Mississippi 39201

CODED

WATER WELL DRILLERS LOG

BUTANE GAS CO. OF GREENWOOD
 POST OFFICE BOX 1135

Leflore

4-28-71 19
 date well completed

GREENWOOD, MISS. 38930 county well located

LANDOWNER: *Jimmie Cole*
Nabo Plantation
Schlater, Miss
 (mailing address)

description of formations encountered	from	to
<i>CLAY</i>	<i>0</i>	<i>18</i>
<i>SAND & GRAVEL</i>	<i>18</i>	<i>90</i>

WELL LOCATION:
 sec. 20 T. 21 N. R. 1 E. P. W
 S. W.
2 1/2 miles NE of Schlater
 (distance) (direction) (nearest town)

WELL PURPOSE:
 (home, irrigation, municipal, industrial)

- WELL COMPLETION DATA:
- (1) diameter (inches) 4"
 - (2) total depth (feet) 90
 - (3) static water level (feet) 18 below above top of ground.
 - (4) casing PVC, 70
 (material) (depth)
4" if telescope see back.
 (size)
 - (5) screen 20', 70
 (length) (depth to top)
4", PVC
 (size) (material)
 - (6) pump 3, 75
 (HP) (yield gpm)
GASOLINE ENGINE
 (type power)
 - (7) electric log No
 (yes or no)

CODED

(organization running log)

MAY 14 1971


(8) how well bottom plugged
PVC cap

DRILLERS REMARKS:

MISS. RD. OF
 WATER COM.

If well telescopes please sketch and show depths.

GROUND LEVEL

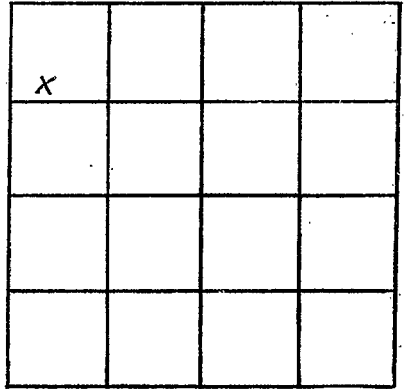

SECTION 20

Please indicate well location X.

ADDITIONAL INFORMATION

If more than one screen, show locations of each on sketch.