

LEFLORE
 D13
 1-23-75
 Ewg#94

MISSISSIPPI
 BOARD OF WATER COMMISSIONERS
 416 North State Street
 Jackson, Mississippi 39201


RECORDED

WATER WELL DRILLERS LOG

January 23 1975 Bruce Berryman - Leflore
 date well completed. firm name: county well located
 Greenwood, Miss.

LANDOWNER: Coley Sanders	description of formations encountered	from	to
Hwy 49, Minter City,	Clay	0	20
Mississippi. 38944	Sand	20	60
(mailing address)	Sand & Gravel	60	120
	Sand & Clay	120	180
WELL LOCATION:	Clay	180	260
sec. 32 T 21 N R 1 E	Sand	260	330
5 S W	Clay	330	410
	Sand	410	420
(distance) miles (direction) of (nearest town)	Sand & Str. clay	420	590
WELL PURPOSE: Home	Sand	590	620
(home, irrigation, municipal, industrial)	Clay	620	640
WELL COMPLETION DATA:	Sand	640	660
(1) diameter (inches) 4" x 2"	Clay	660	690
(2) total depth (feet) 763'	Sand	690	720
(3) static water level (feet) 2' below top of ground	Clay	720	740
4" blk pipe - 105'	Sand	740	765
(4) casing 2" galv. pipe - 637'	Clay	765	780
(material) (depth)	Sand	780	790
(size) If telescope see back.	Clay	790	806
(5) screen 20' 743'	Sand	806	820
(length) (depth to top)	Sand & Str. clay	820	900
2" .010 stainless steel	Clay	900	920
(size) (material)			
(6) pump 3/4 30			
(HP) (yield gpm)			
Electric			
(type power)			
(7) electric log Yes			
(yes or no)			
Miss. Geological Survey			
(organization running log)			
(8) how well bottom plugged B.P.V			
DRILLERS REMARKS:			

RECORDED

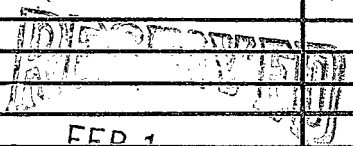


FEB 13 1975

MISS. BD. OF WATER COMM

If well telescopes please sketch and show depths.

GROUND LEVEL

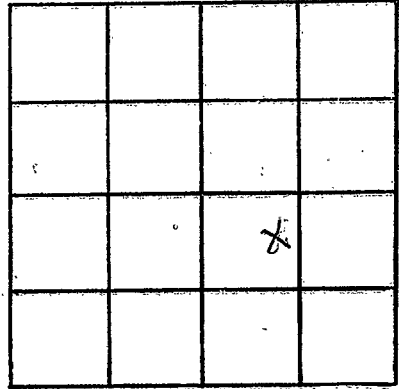

SECTION 32

Please indicate well location X.

ADDITIONAL INFORMATION

If more than one screen, show locations of each on sketch.