

LEFLORE
D 14
3.6.75

MISSISSIPPI
 BOARD OF WATER COMMISSIONERS
 416 North State Street
 Jackson, Mississippi 39201

WATER WELL DRILLERS LOG

3-6-75 19 BUTANE GAS CO. OF GREENWOOD Leflore
 date well completed firm name county well located

LANDOWNER:
BROWN FARMS
Schlater
 (mailing address)

description of formations encountered	from	to
<u>Sandy Clay</u>	<u>0</u>	<u>10</u>
<u>SAND</u>	<u>10</u>	<u>20</u>
<u>Clay SAND & GRAVEL</u>	<u>20</u>	<u>30</u>
<u>SAND & GRAVEL</u>	<u>30</u>	<u>97</u>

WELL LOCATION:
 sec. 30 T 14 N R 1 E
21 S W
1 1/2 miles NE of Schlater
 (distance) (direction) (nearest town)

WELL PURPOSE: FR
 (home, irrigation, municipal, industrial)

- WELL COMPLETION DATA:
- (1) diameter (inches) 6"
 - (2) total depth (feet) 97
 - (3) static water level (feet) 12 below top of ground.
 - (4) casing Steel, 57
 (material) (depth)
6" If telescope see back.
 (size)
 - (5) screen 40, 57
 (length) (depth to top)
6", Steel
 (size) (material)
 - (6) pump 40, 1000
 (HP) (yield gpm)
Diesel
 (type power)
 - (7) electric log No
 (yes or no)
- (organization running log)

(8) how well bottom plugged
Steel Plate


DRILLERS REMARKS:

RECEIVED
 MAR 21 1975

MISS. BD. OF WATER COMMISSIONERS

If well telescopes please sketch and show depths.

GROUND LEVEL

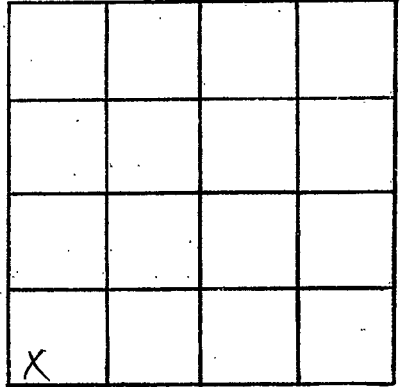

SECTION 30

Please indicate well location X.

ADDITIONAL INFORMATION

If more than one screen, show locations of each on sketch.