

MISSISSIPPI BOARD OF WATER COMMISSIONERS

*Leflore*  
**D 20**  
*6-66*

**WATER WELL DRILLERS LOG CODED**

Date: 6/11, 19 66, Driller: Butane Gas Co. County Leflore  
(Name)

(1) Owner of Land: <u>Bill Brown</u> (Name) <u>Schlater, Miss.</u> (Address) (2) Location: <u>SW 1/4, NE 1/4, Sec. 19 21 1 T1N RW</u> <u>2 1/2</u> miles <u>NE</u> , of <u>Schlater</u> (distance) (direction) (Nearest Town) (3) Topography: <input checked="" type="checkbox"/> (Hilly) <input type="checkbox"/> (Flat) <input type="checkbox"/> (Level) (4) Purpose of Well: <u>Irrigation</u> (Domestic Irrigation Municipal, Industrial, Other)	Description & Color of Materials Sand, Clay, Red Clay, Shell, etc.	Thick- ness Feet	Depth Feet
	Clay	13	13
	Clay	10	23
	Coarse Sand	10	33
	Coarse Sand	10	43
	Coarse Sand, Gravel	10	53
	Coarse Sand, Gravel	10	63
	Coarse Sand, Gravel	10	73
	Coarse Sand, Gravel	10	83
Coarse Sand, Gravel	10	93	

Information upon completion of well:


- (1) Diameter 16 inches.
- (2) Total Depth 93 feet.
- (3) Water Level 20 feet below top of ground.
- (4) Cased to 53, Size 16
- (5) Screen: Size 16, Length 40
- (6) Were any formations sealed against pollution?  
yes,  no.

If YES depth of formation \_\_\_\_\_

Why \_\_\_\_\_

Drillers Remarks: \_\_\_\_\_

**CODED**

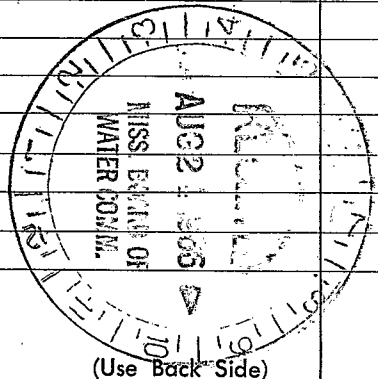

(Use Back Side)

Well No.

Retain this copy for your office files.

100-1000